


T. 39S.R.3W.W.M.

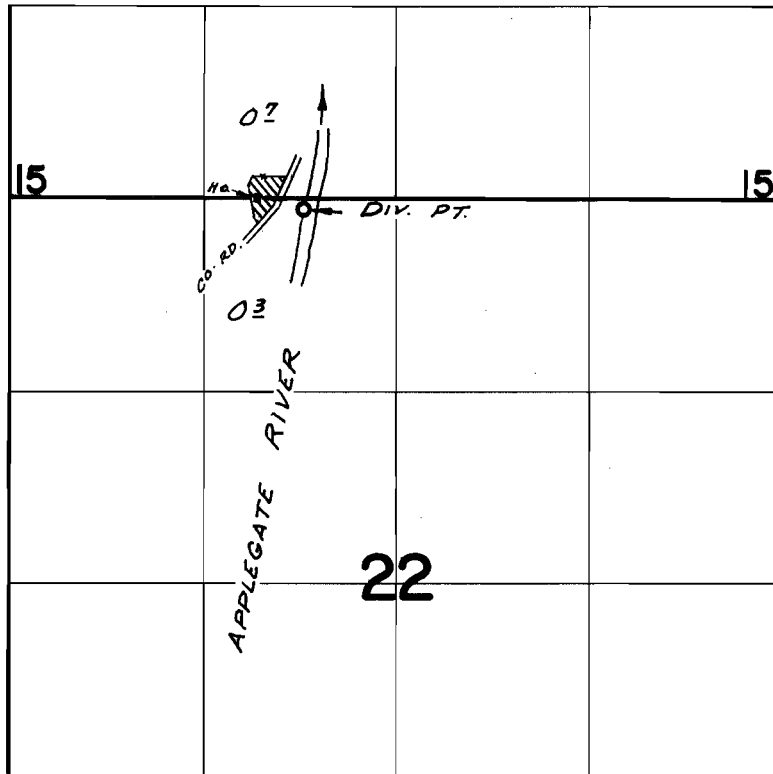

DIV. PT. LOC: 70'S. & 2,010'E. FROM N.W. COR. SEC. 22

**FINAL PROOF SURVEY**  
UNDER

Application No. 41013 Permit No. 30578  
IN NAME OF

DAID T. THOMPSON

Surveyed AUG. 12, 1971, by G. BACA