


T. 36S. R. 1E. W.M.

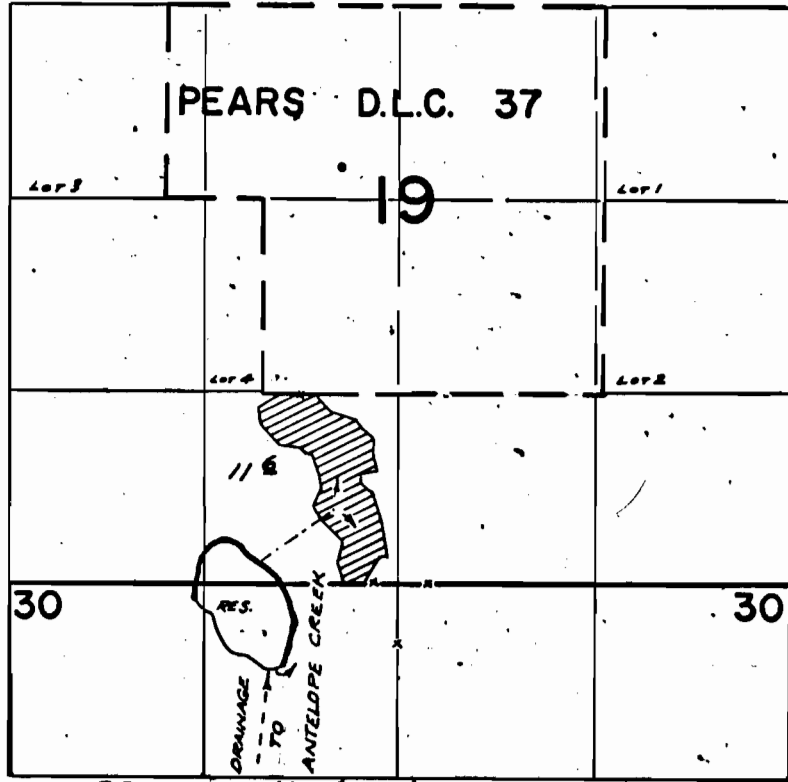

DIV. PT. LOC: 140' N. & 940' W. FROM S 1/2 COR. SEC. 19

FINAL PROOF SURVEY
UNDER

Application No. ~~41423~~ ^{R-41423} Permit No. ~~30616~~ ^{R-4604}
IN NAME OF

.....**VERNE R. HARPER**.....

Surveyed Aug. 5, 1971, by G. BACA.....