


T. 38S.R.8W.W.M.

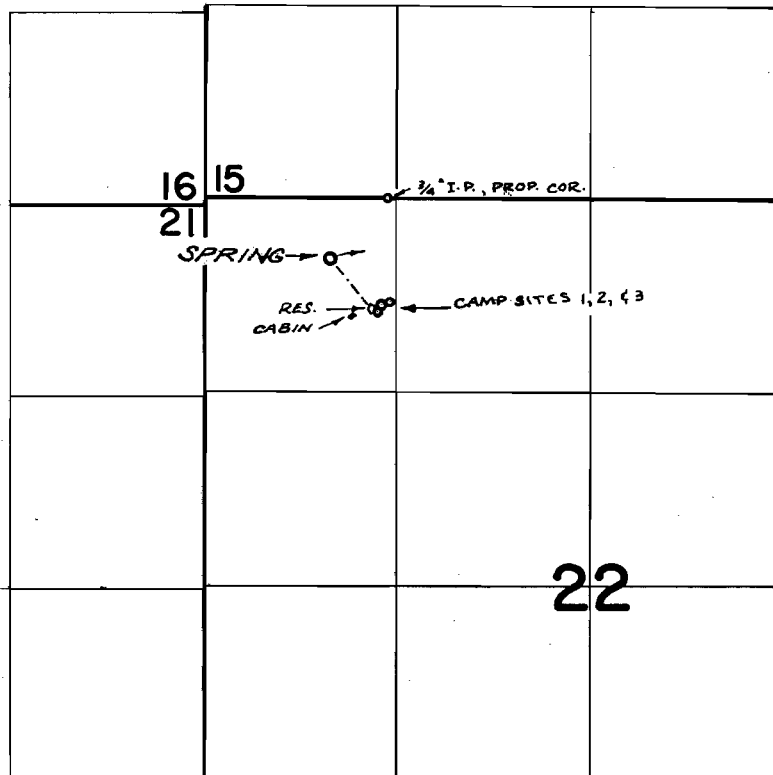

DIV. PTS. Loc: SPRING - 420'S. & 850'E., RES. - 750'S. & 1130'E,
BOTH FROM N.W. COR. SEC. 22

FINAL PROOF SURVEY
UNDER

Application No. R-42857 42803 Permit No. R-4873 32003
IN NAME OF

HERBERT G. DORSEY

Surveyed JUNE 16, 1971, by G. BACA