


T. 9 S. R. 1 E. W. M.

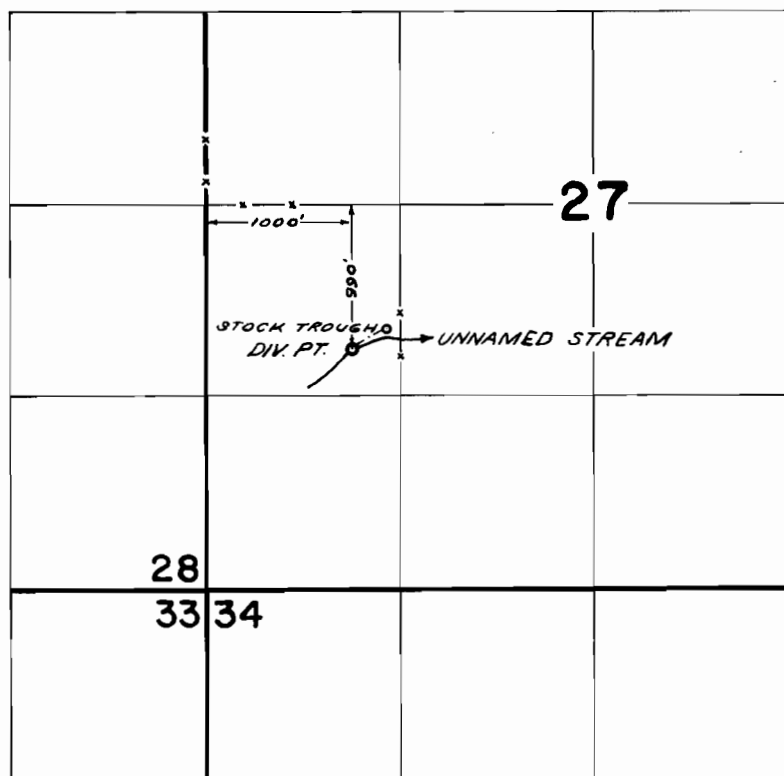

FINAL PROOF SURVEY
UNDER

Application No. 46666 Permit No. 34866
IN NAME OF

ANDREW J. & GRACE A. SILBERNAGEL

Surveyed JUN. 23 1971, by D. BUELL