


T. 6 S. R. 2 W. W. M.

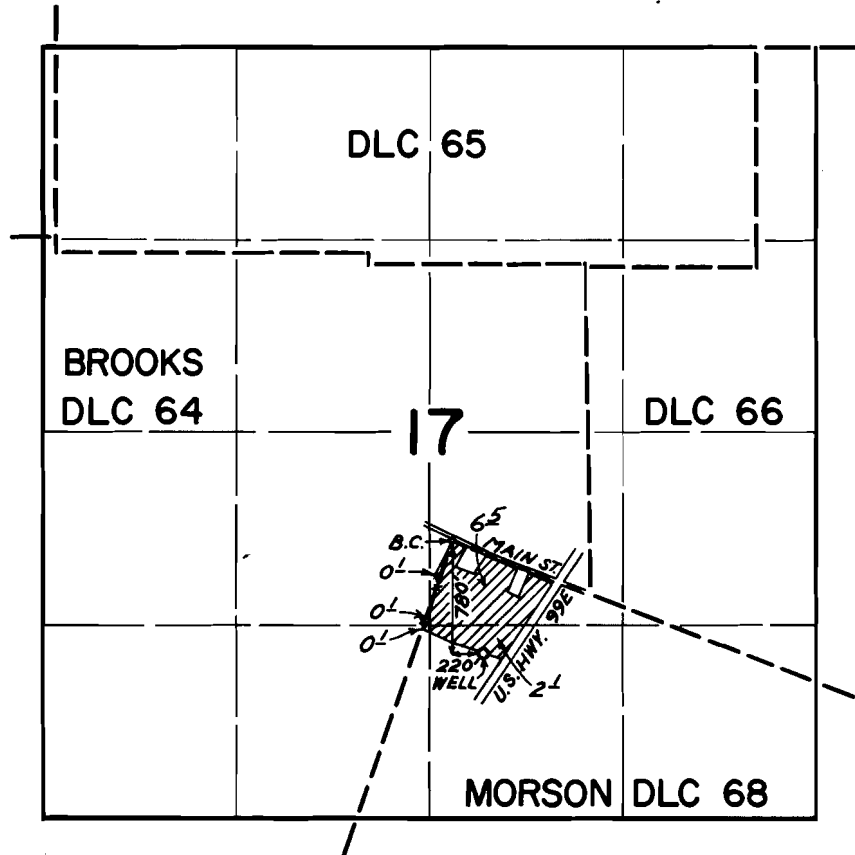

FINAL PROOF SURVEY
UNDER

Application No. G-4213 Permit No. G-4004
IN NAME OF

BROOKS HARDWARE, INC.

Surveyed AUG. 20 1971, by GREG BACA