


T. 6 S. R. 2 W. W. M.

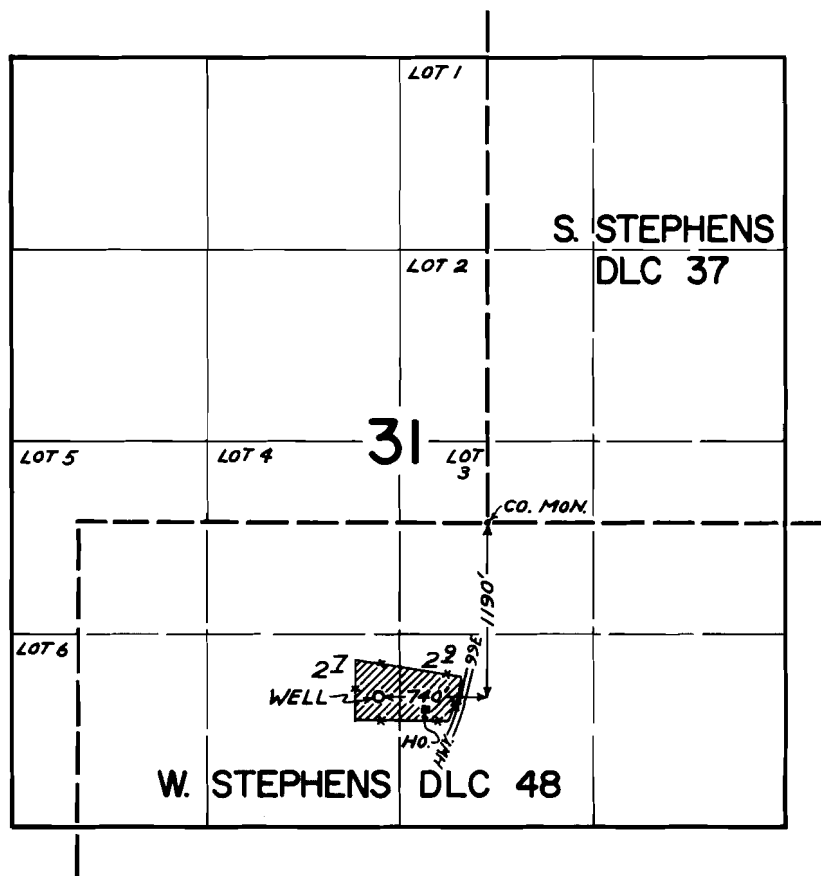

FINAL PROOF SURVEY
UNDER

Application No. G-4329 Permit No. G-4084
IN NAME OF

CLIFFORD D. CONRAD

Surveyed SEPT. 10, 1971, by GREG. BACA