


T. 6 S. R. 2 W. W. M.

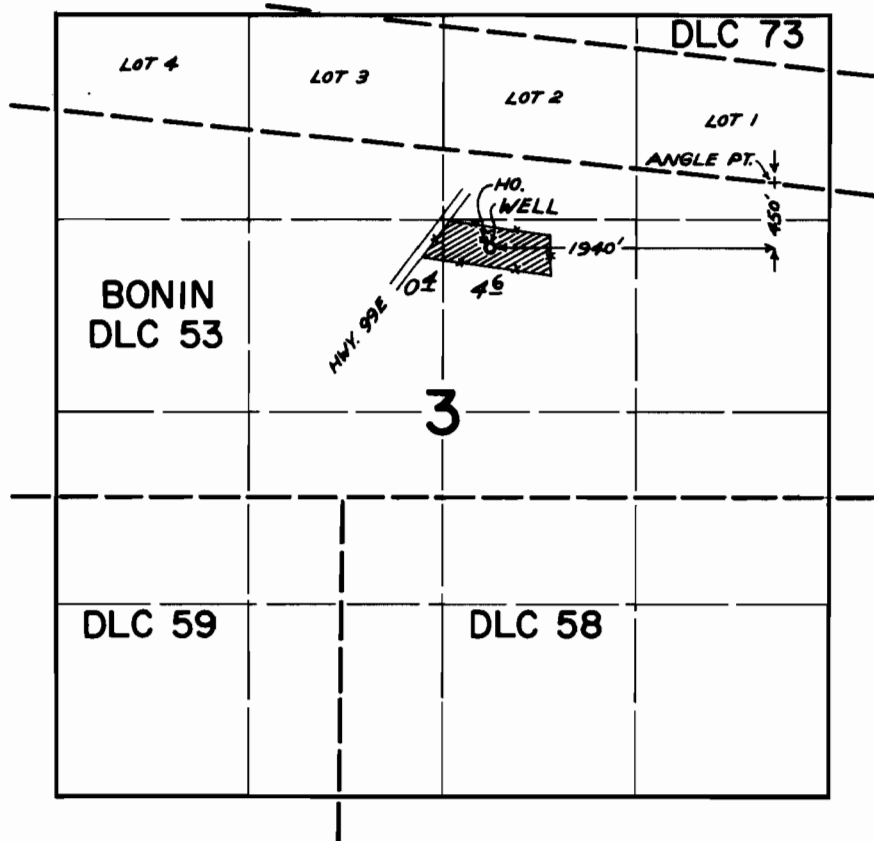

FINAL PROOF SURVEY UNDER

Application No. ~~G-1411~~... Permit No. ~~G-1157~~...
IN NAME OF

RAY ZORN

Surveyed ~~SEPT. 10~~ 1971., by ~~GREG BACA~~.....