


T I S R. I O W. W. M.

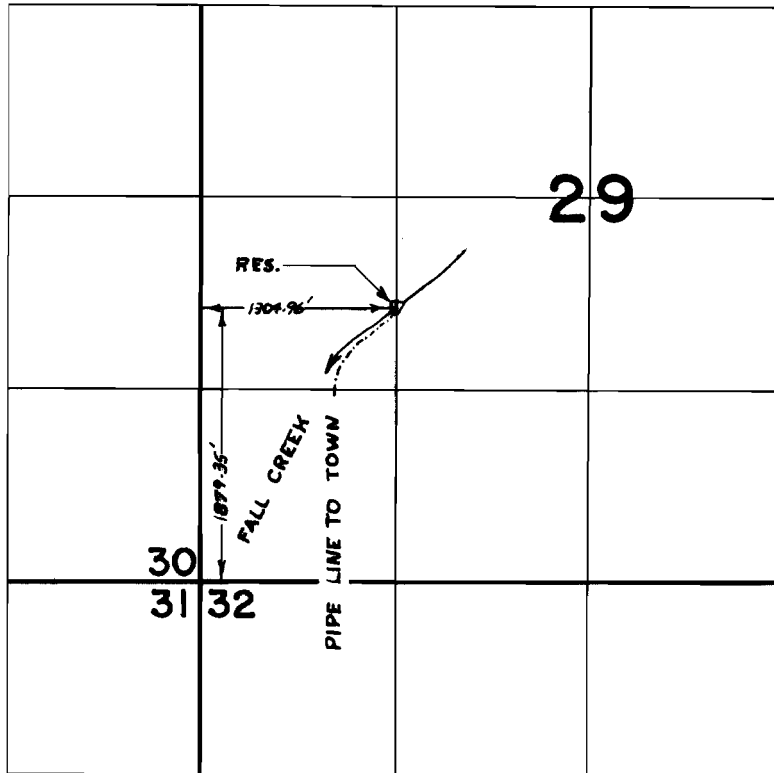

DIV. PT. LOC. FROM APPLICATION MAP

FINAL PROOF SURVEY UNDER

R-38531 R-3213
Application No. 38249 Permit No. 28564
IN NAME OF

NETARTS WATER DISTRICT

Surveyed AUG. 5., 1971., by R. MUCKEN