


T. 1 S. R. 9 W. W. M.

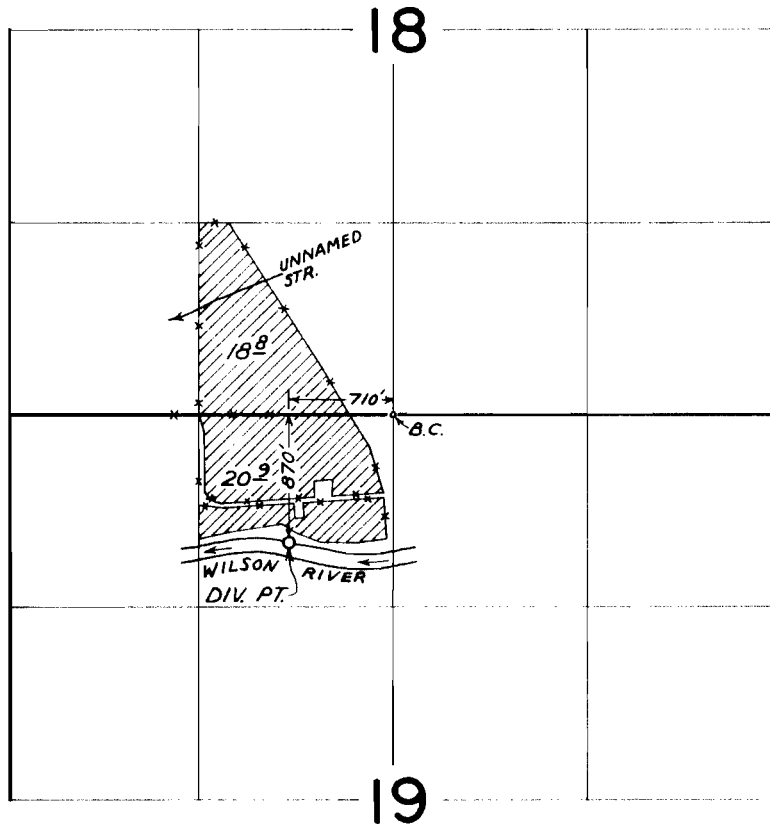

FINAL PROOF SURVEY  
UNDER

Application No. 38998 ... Permit No. 29051 ...  
IN NAME OF

ESTATE OF LYMOND HANENKRAT

Surveyed JUNE 9 1971, by GREG BACA