


T. 4 S. R. 10 W. W. M.

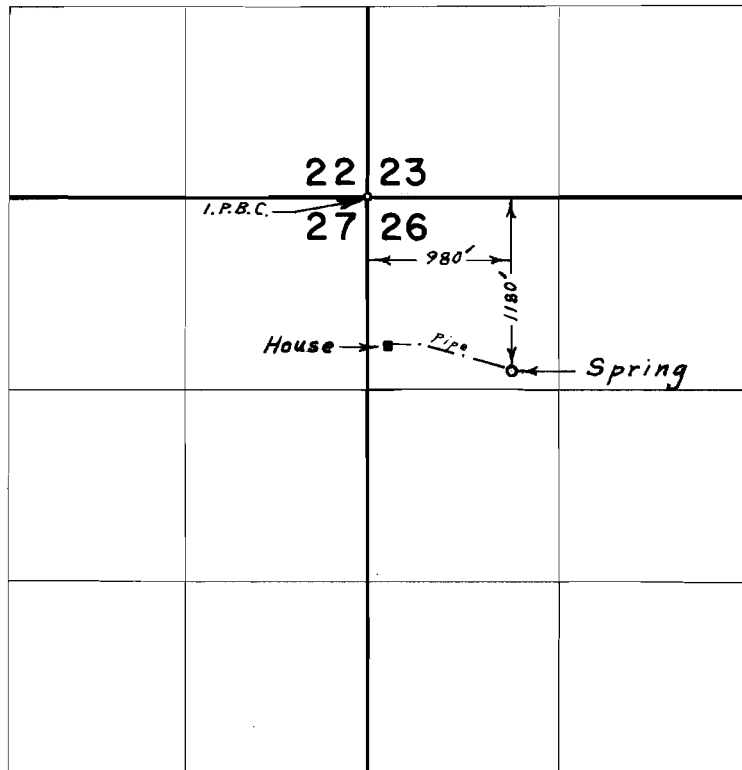

FINAL PROOF SURVEY UNDER

Application No. 40893 Permit No. 30481
IN NAME OF

GORDEN J. & ELIZABETH A. BAERTLEIN

Surveyed Aug. 13, 1971, by L. E. Gould