


T.6N.R.35E.W.M.

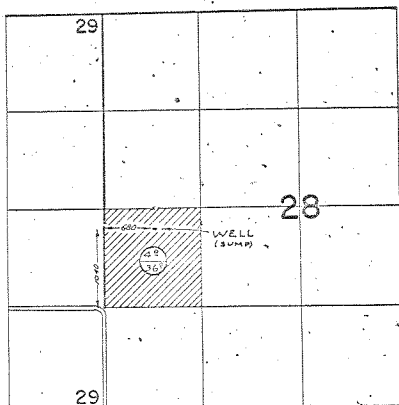

FINAL PROOF SURVEY  
UNDER

Application No. *G-2692* Permit No. *G-2704*  
IN NAME OF

SYBIL McK. BUCHWALTER & SYLVIA E. TURNER

Surveyed *MAY 8 1971*, by *G. BACA*