


T.6N.R.36E.W.M.

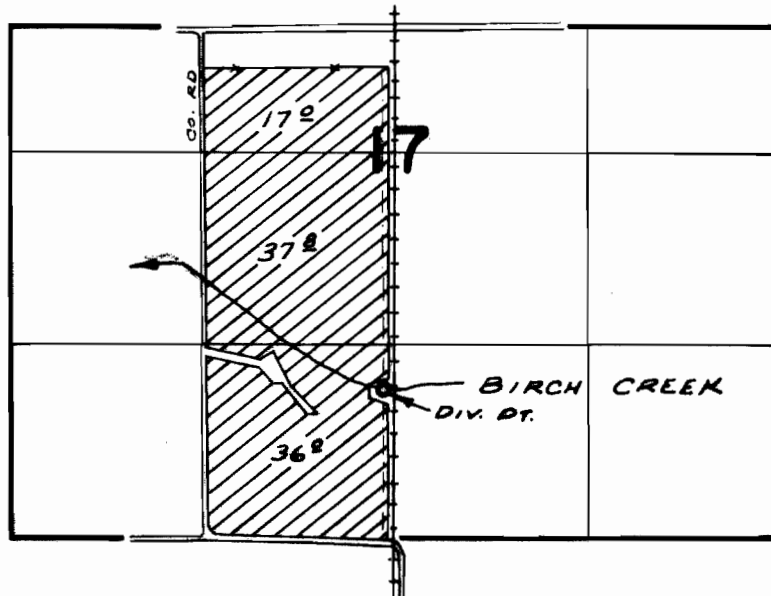

Div. Pt. located i- 1020 ft. N. of 70 ft. W. from S.W. cor. Sec. 17

FINAL PROOF SURVEY
UNDER

Application No. 41471 Permit No. 30737
IN NAME OF

VITO A. MORAMARCO

Surveyed SEPT. 2, 1971, by R. MUCKEN