


T. 1 N. R. 4 W. W. M.

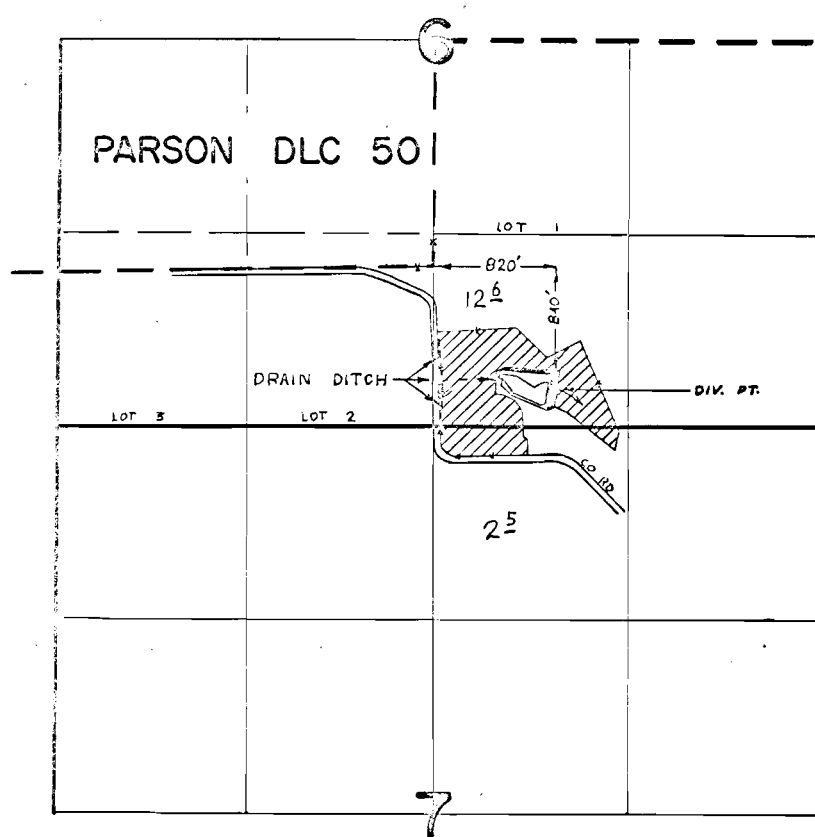

FINAL PROOF SURVEY
UNDER

Application No. R...⁴²³²⁰42357 Permit No. R...³¹²⁴²4727...
IN NAME OF

.....DALE RATH.....

Surveyed JUNE 15, 1971., by R...MUCKEN.....