


T. 1 N. R. 4 W. W. M.

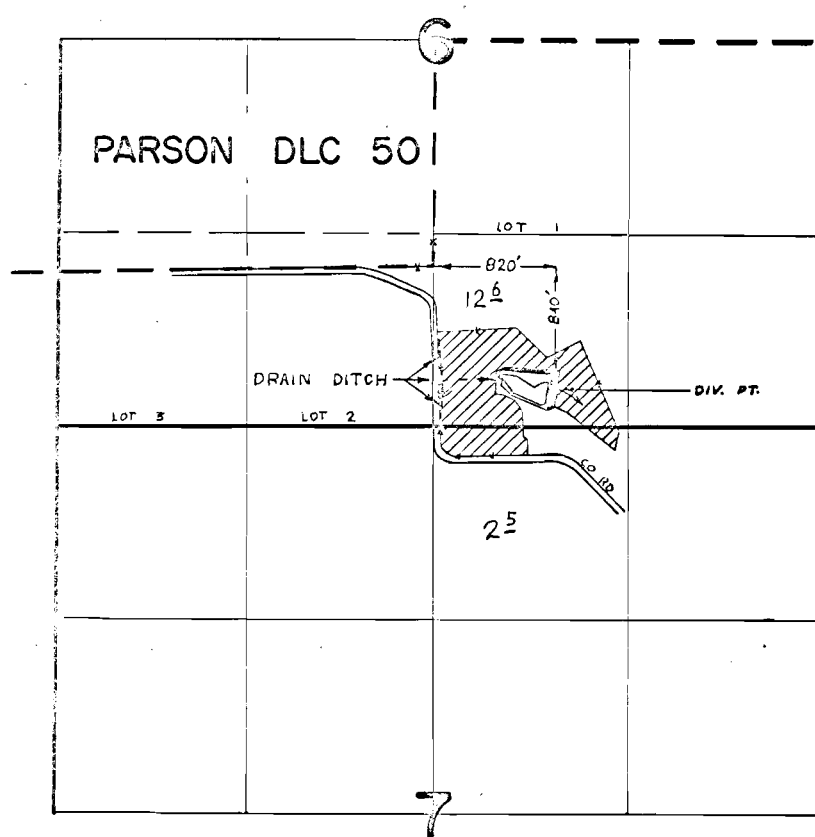

FINAL PROOF SURVEY  
UNDER

Application No. R...<sup>42320</sup>42357 Permit No. R...<sup>31242</sup>4727...  
IN NAME OF

.....DALE RATH.....

Surveyed JUNE 15, 1971., by R...MUCKEN.....