


T. 1 S. R. 4 W. W. M.

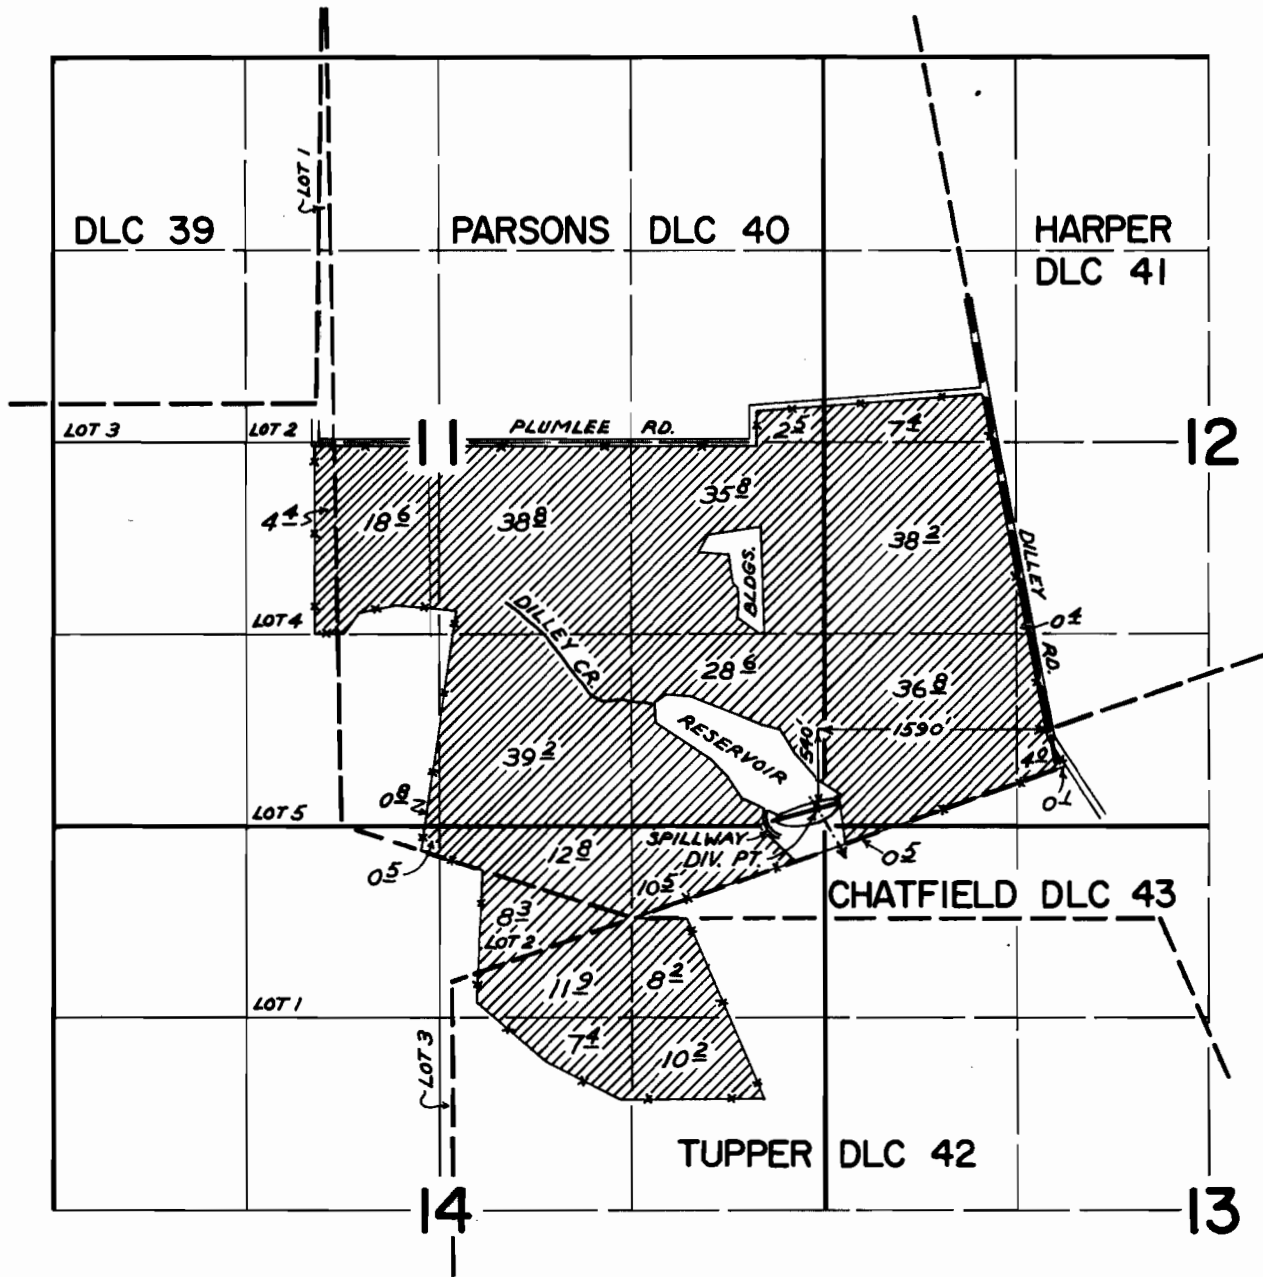

FINAL PROOF SURVEY UNDER

Application No. R-42398 42399 Permit No. R-4736 31262
IN NAME OF

LEO G. GRAHAM

Surveyed MAY 24 & 25 1971, by GREG BACA