


# T. 1 S. R. 4 W. W. M.

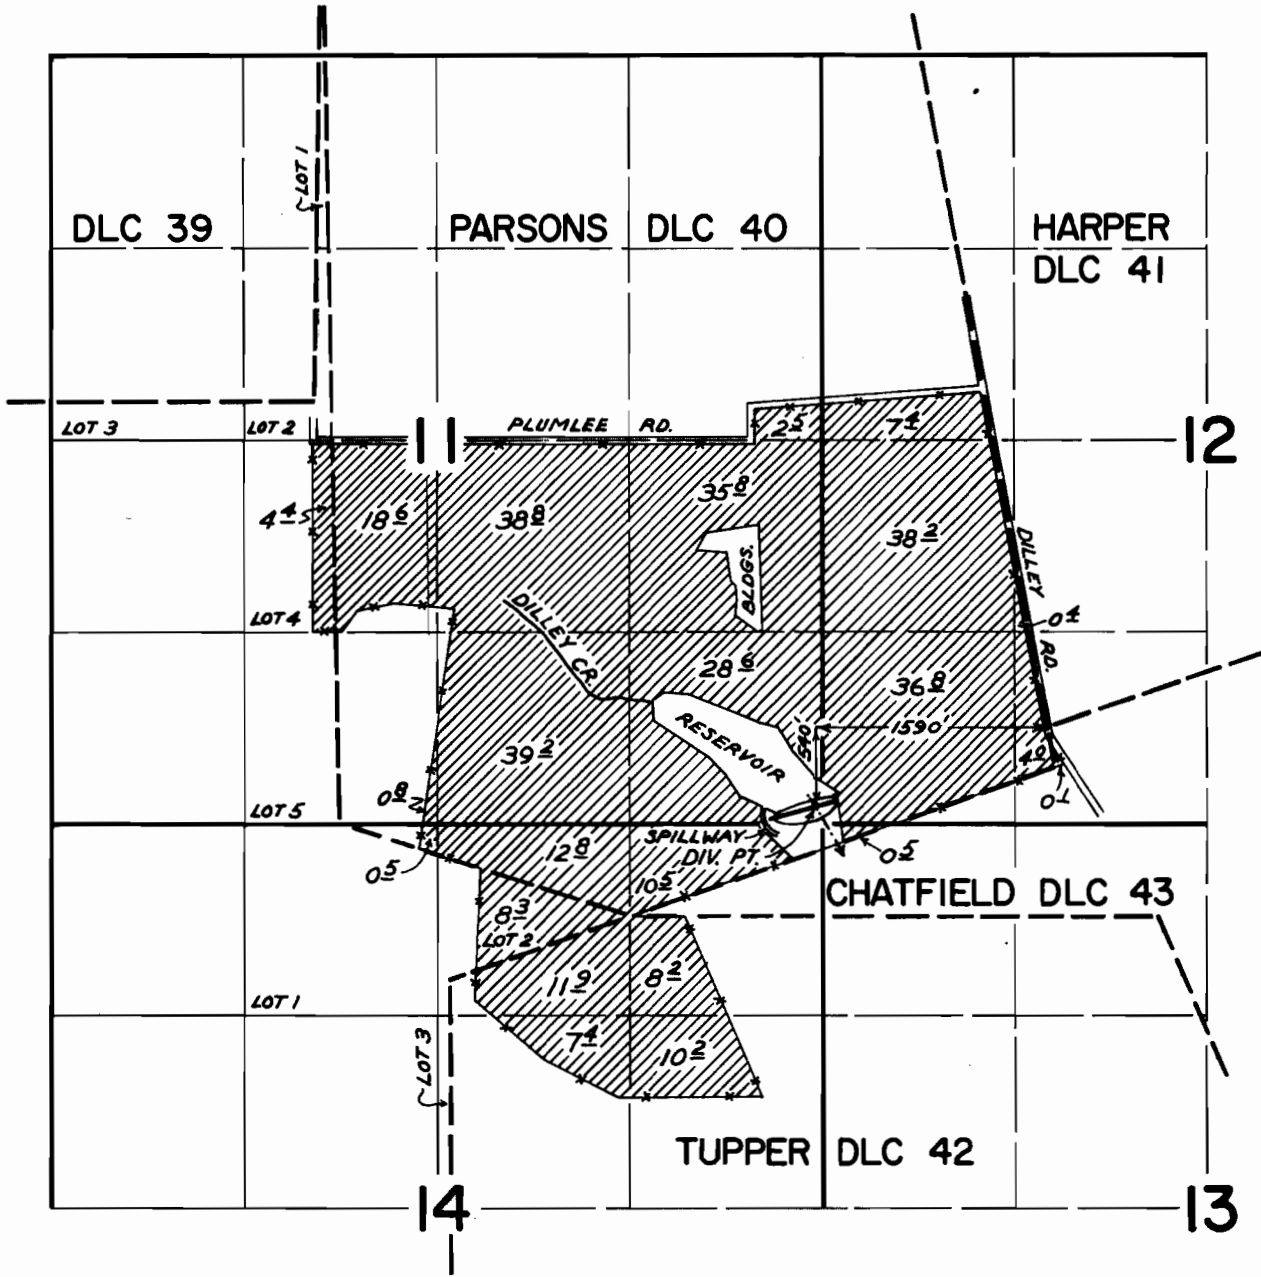

## FINAL PROOF SURVEY UNDER

Application No. R-42398 Permit No. R-4736  
42399 31262  
 IN NAME OF

LEO G. GRAHAM

Surveyed MAY 24 & 25 1971, by GREG BACA