


T 32 R 3 E Sec. \_\_\_\_\_ Subdiv. \_\_\_\_\_ N. F.

Mapped by Bert G. Hanson Corrected by \_\_\_\_\_ Scale 2 inches=1 Mile

July 2 1917

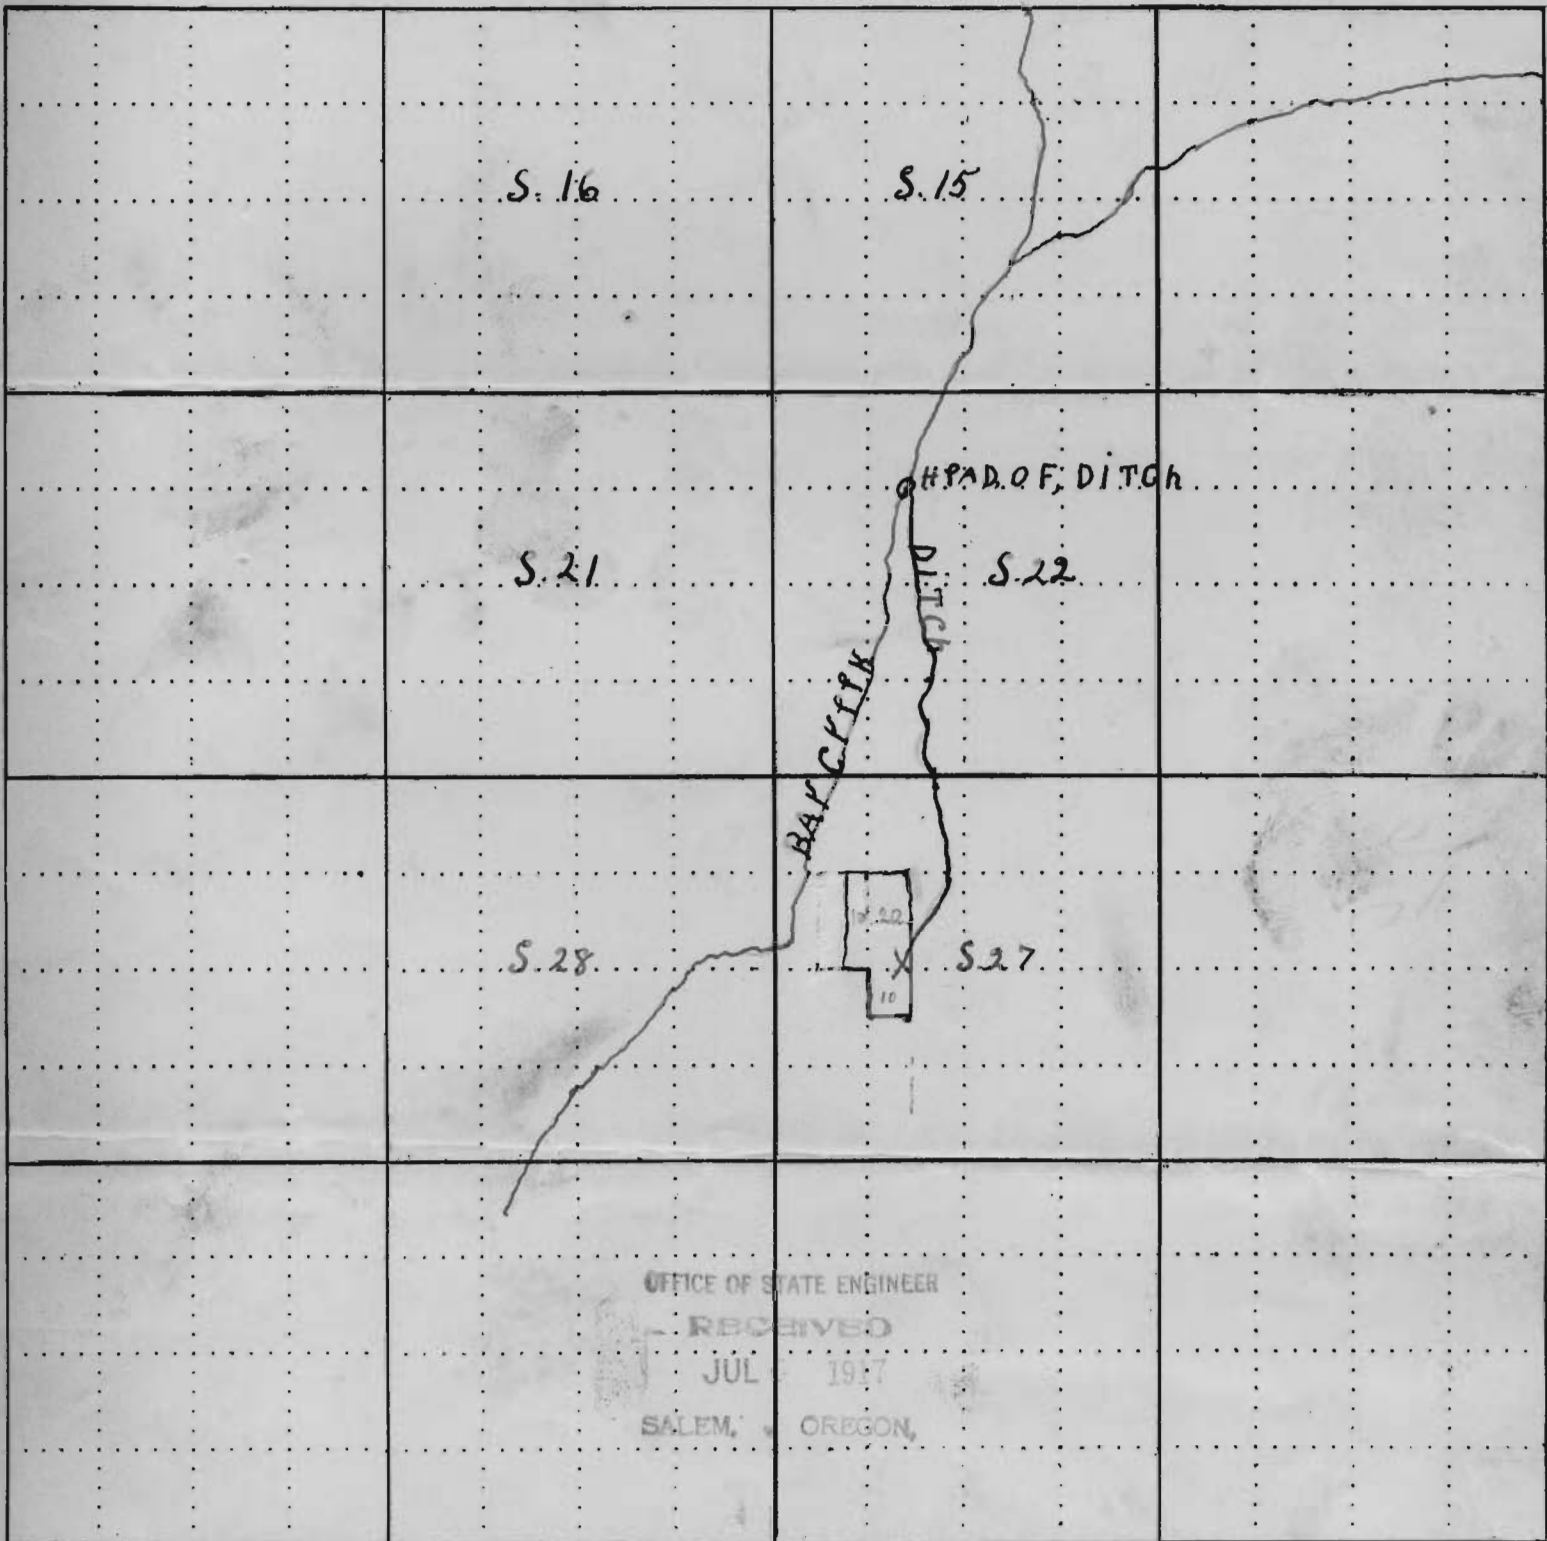

Application No. 5613  
Permit No. 3433