


T. 3 S. R. 4 W. W. M.

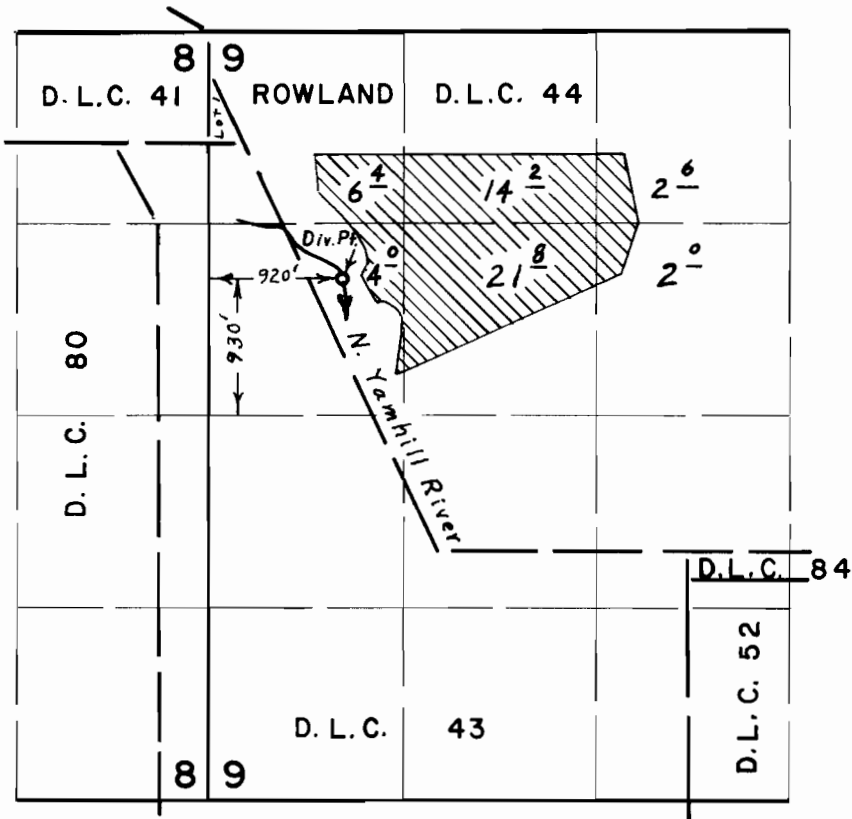

FINAL PROOF SURVEY
UNDER

Application No. 46123 Permit No. 34459
IN NAME OF

HUGH HUDSON

Surveyed Oct. 27, 1971, by L. E. Gould