


T. 3 S. R. 5 W. W. M.

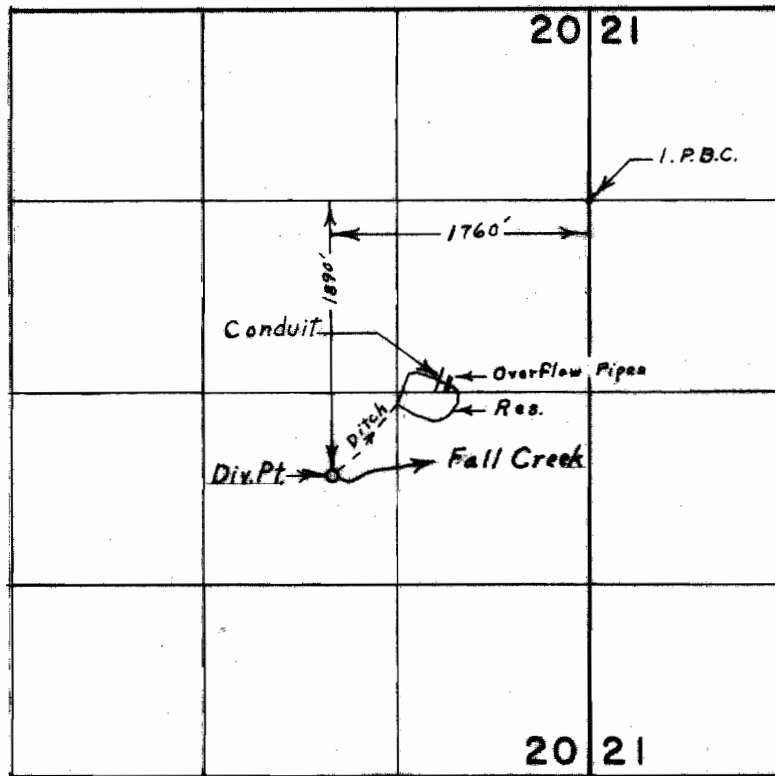

**FINAL PROOF SURVEY**  
UNDER

R-41987 R-4778  
Application No. 42098 Permit No. 31451  
IN NAME OF

**RICHARD N. VON**

Surveyed Oct. 29, 1971, by L. E. Gould.