


T. 3 S. R. 5 W. W. M.

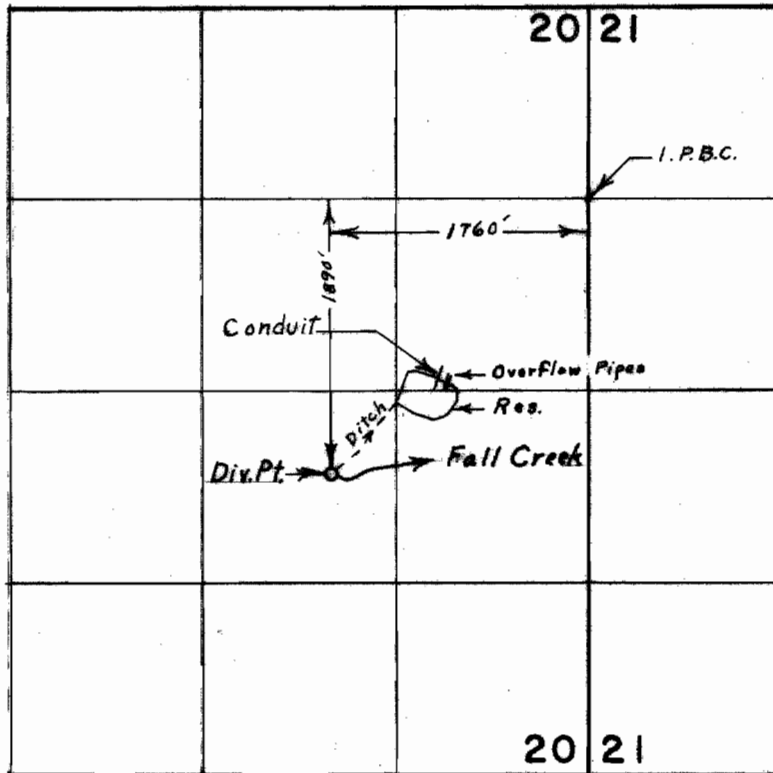

FINAL PROOF SURVEY
UNDER

R-41987 R-4778
Application No. 42098 Permit No. 31451
IN NAME OF

RICHARD N. VON

Surveyed Oct. 29, 1971, by L. E. Gould