


T. 3 S. R. 4 W. W. M.

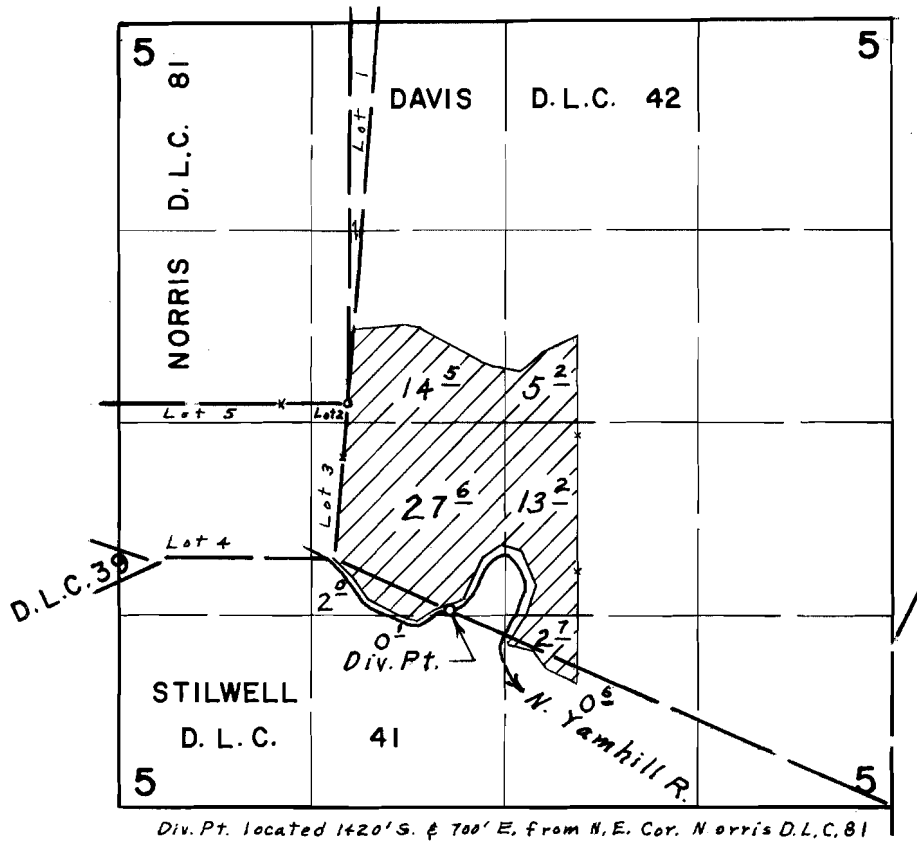

FINAL PROOF SURVEY UNDER

Application No. 43966 Permit No. 32845
IN NAME OF

HARRY H. WILLIAMS

Surveyed Nov. 17, 1971, by L. E. Gould