



T.2S.R.3W.W.M.

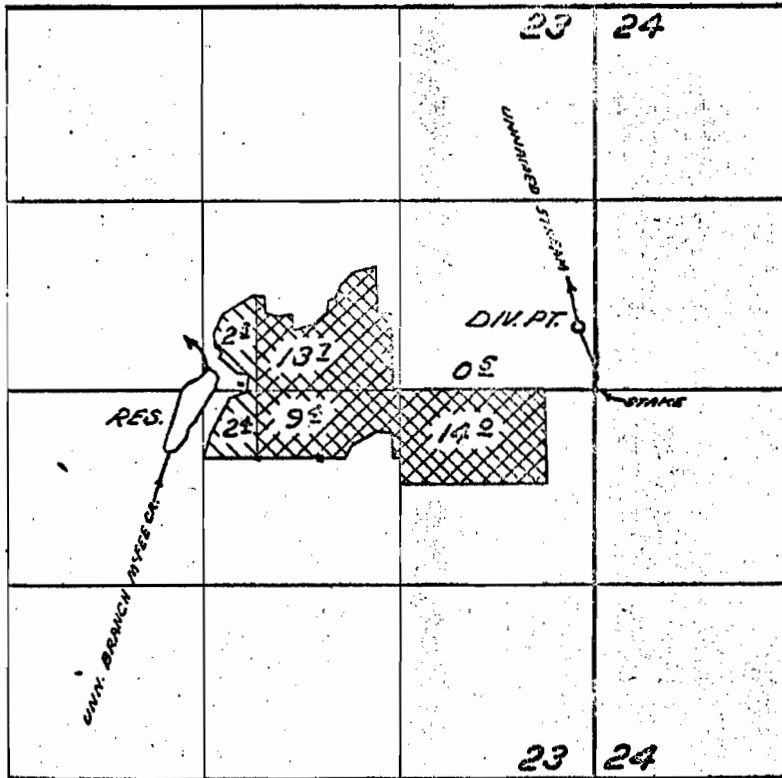

DIV. PTS. LOCATED:  
 UNN. STREAM - 440' N. & 120' W.  
 RESERVOIR - 150' N & 2610' W.  
 BOTH FROM E 1/4 COR. SEC. 23



UNN. STR.

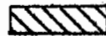

RESERVOIR & UNN. BRANCH

**FINAL PROOF SURVEY**  
 UNDER

Application No. R-38437 38433 Permit No. R-3271 28375  
 IN NAME OF

ROBERT A. WEAVER

Surveyed AUG 11 1967, by V. GARNER

Application No. R-44722  
& 44723  
 Permit No. R-38911 33506