


T. 3 S. R. 4 W. W. M.

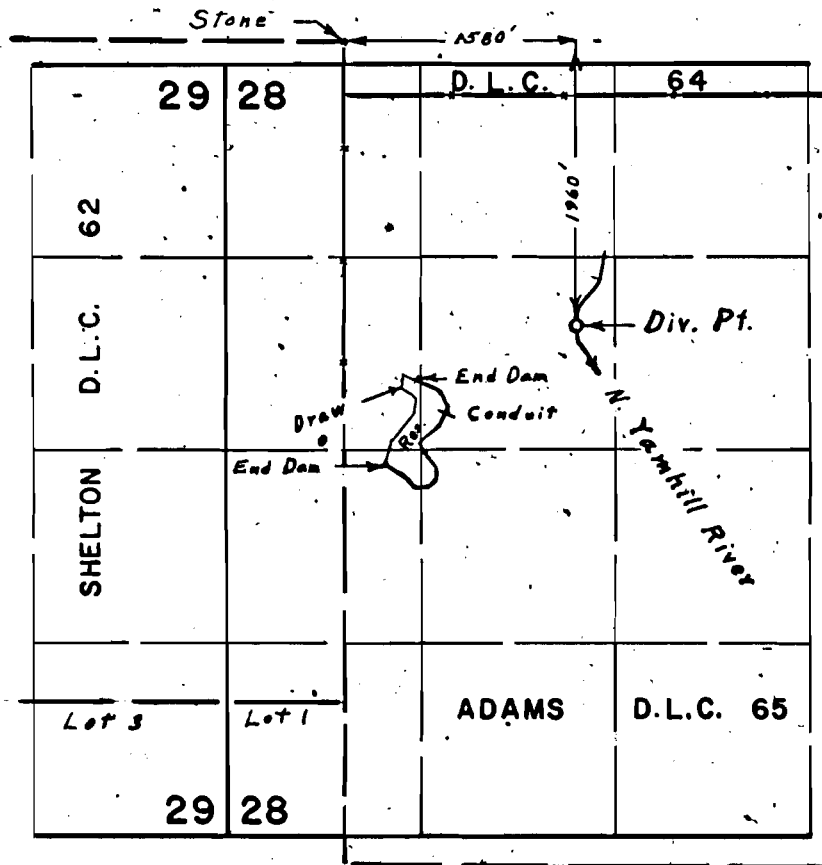

FINAL PROOF SURVEY UNDER

R-46283 R-5436
 Application No. 46284 Permit No. 34202
 IN NAME OF

NEW ENGLAND BOLT & THREAD CO.

Surveyed Nov. 16, 1971, by L. E. Gould.