


# T. 2 S. R. 5 W. W.M.

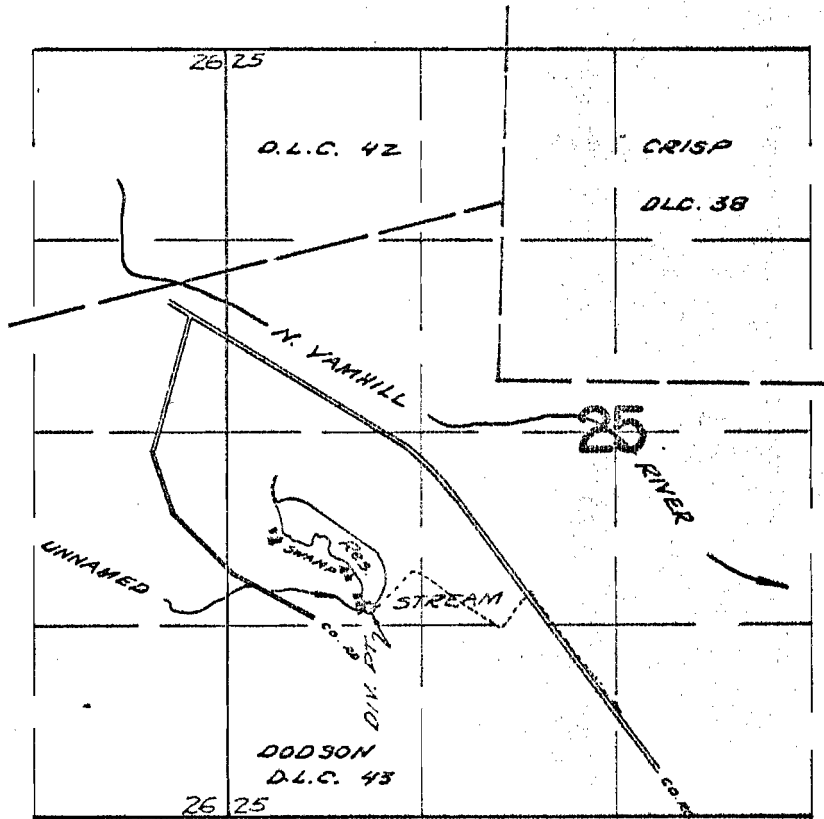

Div. Pt. located 1560 ft. S. & 880 ft. W. from  
the S.W. corner of CRISP D.L.C. # 38

## FINAL PROOF SURVEY UNDER

Application No. <sup>R-40409</sup> 40410... Permit No. <sup>R-4564</sup> 30370...  
IN NAME OF

..... HARLEY S. BELT .....

Surveyed Sept. 8 1967, by V. Garner.....

Application No. R-44970  
Permit No. R-5308