


# T.5S.R.1E.W.M.

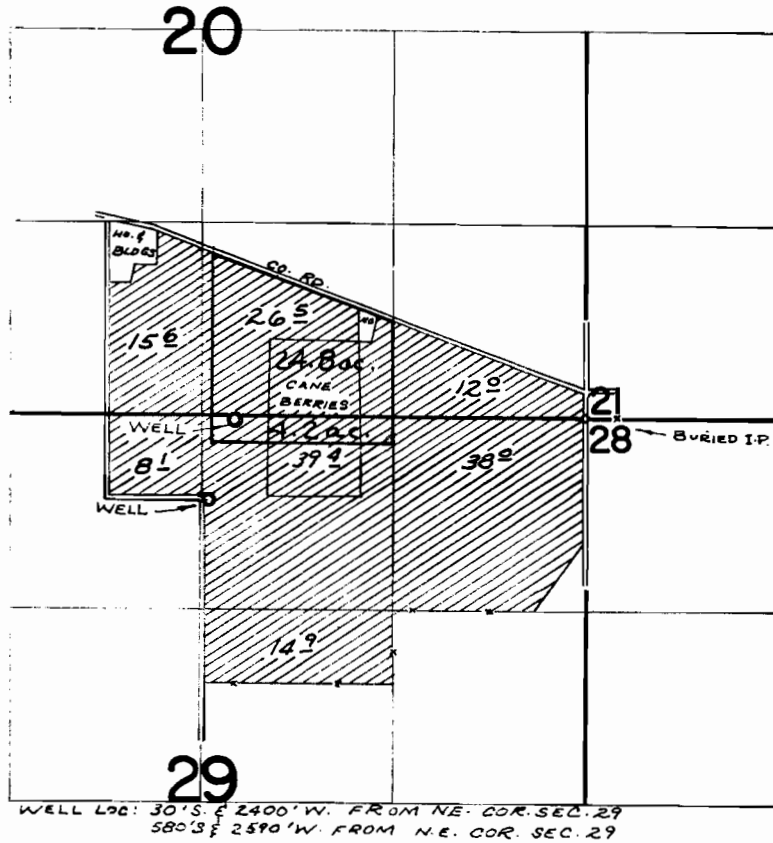

## FINAL PROOF SURVEY UNDER

G-4763                      G-4487  
Application No. G-3133    Permit No. G-2069  
IN NAME OF

JOHN BECK

Surveyed APR. 6, 1971 by R. MUCKEN...

*Part to be  
canceled*