


T. 4 S. R. 3 E. W. M.

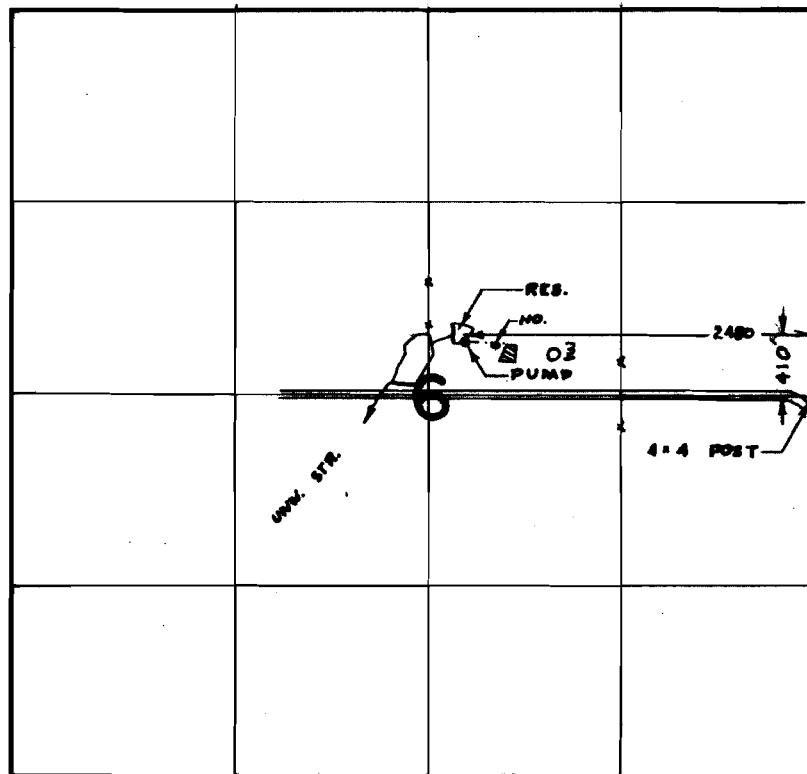

FINAL PROOF SURVEY
UNDER

R-44095 R-4963
Application No. ~~44095~~ Permit No. ~~32365~~
IN NAME OF

.....JOHN McCULLER.....

Surveyed APR. 27 & 28 1971., by R. MUCKEN.....