


T. 4 S. R. 3 E. W. M.

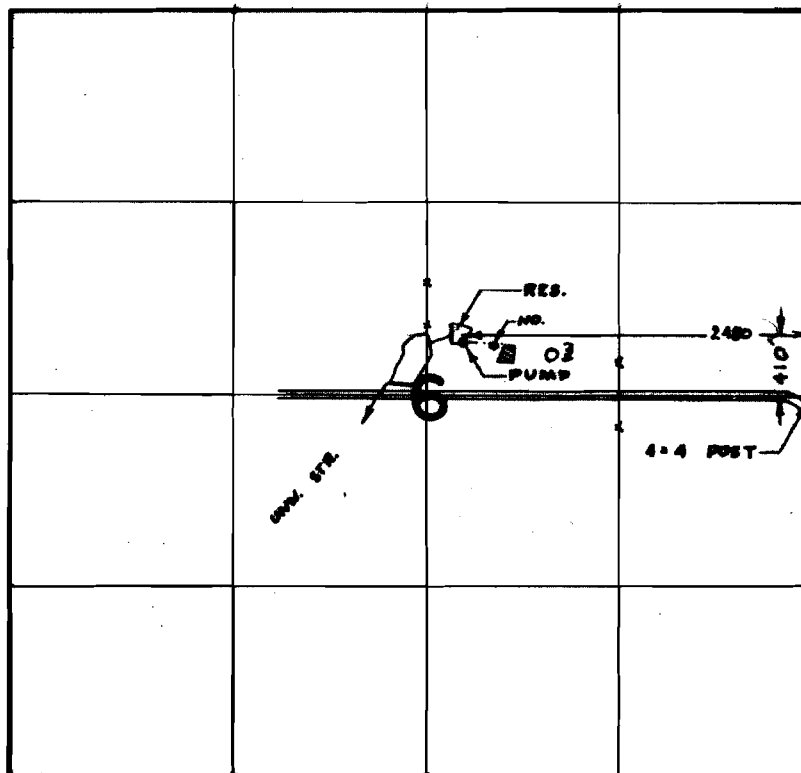

FINAL PROOF SURVEY
UNDER

R-44095 R-4963
Application No. 44095 Permit No. 32365
IN NAME OF

JOHN McCULLER

Surveyed APR. 27 & 28 1971, by R. MUCKEN