


T. 4 N. R. 9 W. W. M.

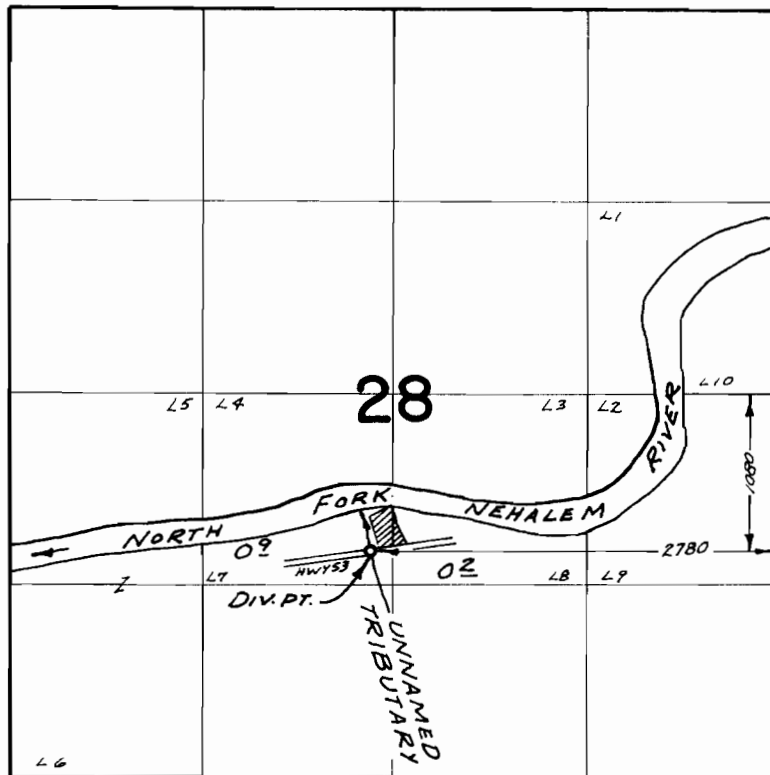

FINAL PROOF SURVEY UNDER

Application No. 41559 Permit No. 31001
IN NAME OF

REX I. PEFFER

Surveyed JULY 22, 1971, by G. BACA