

UNITED STATES DEPARTMENT OF AGRICULTURE
Soil Conservation Service
Oregon


LOCATION OF ~~A.C.P. PRACTICES~~ Domestic Water System
Program Year 1964

Operator Delos Ellis

A.C.P. Farm No. _____

County Coos

Section 23 Township 28 S Range 12 W, W.M. Aerial Photo No. COB-3A-7

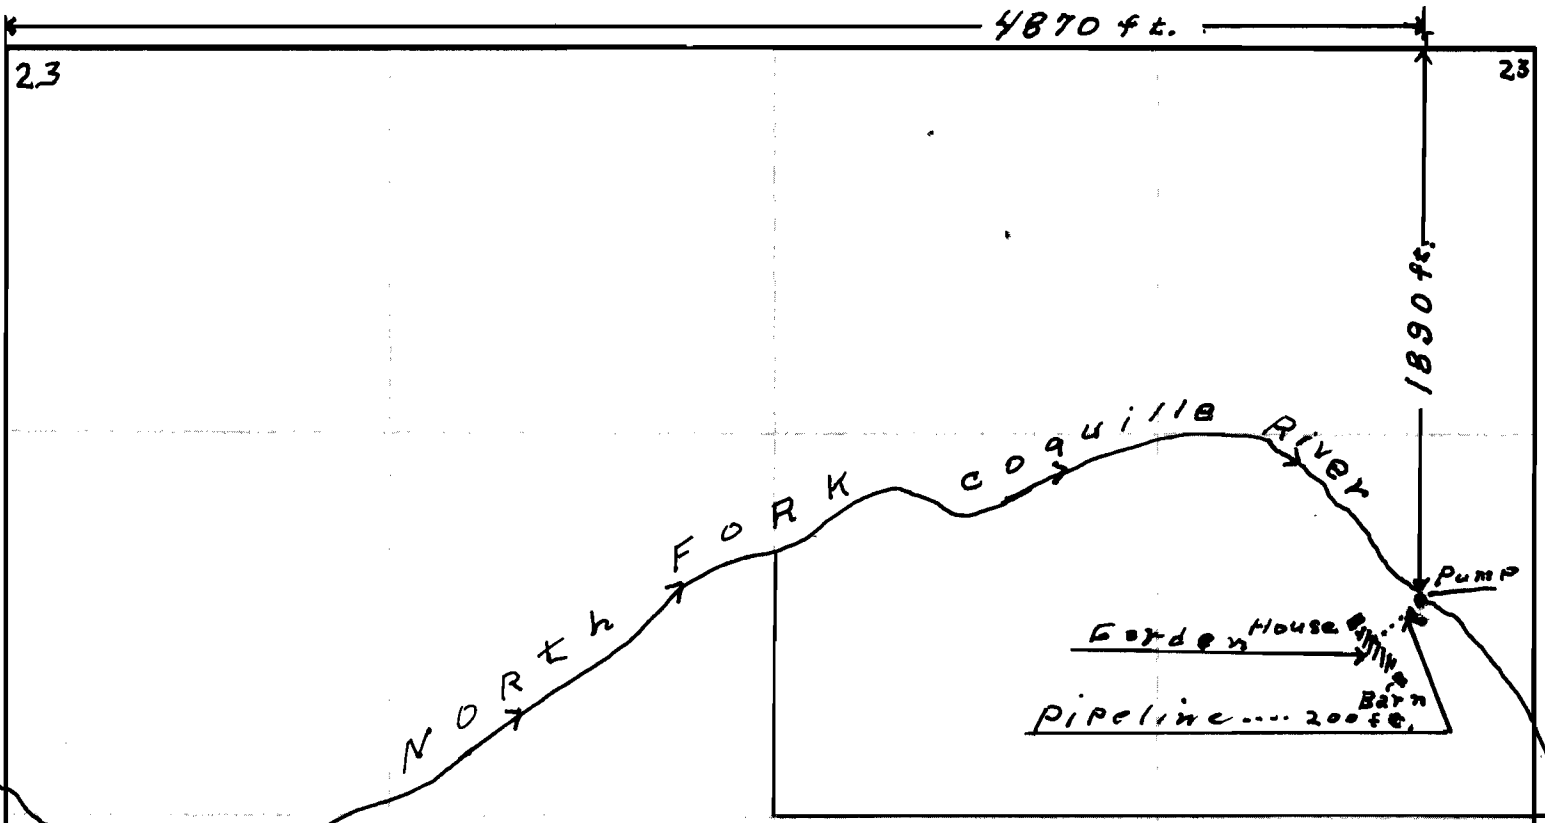

-Approximate-
Scale 660' = 1 in
Tracing Prepared by
Carl Holland, Jr.



Application No. 39506
Permit No. 29320