


T. 25S.R.5W.W.M.

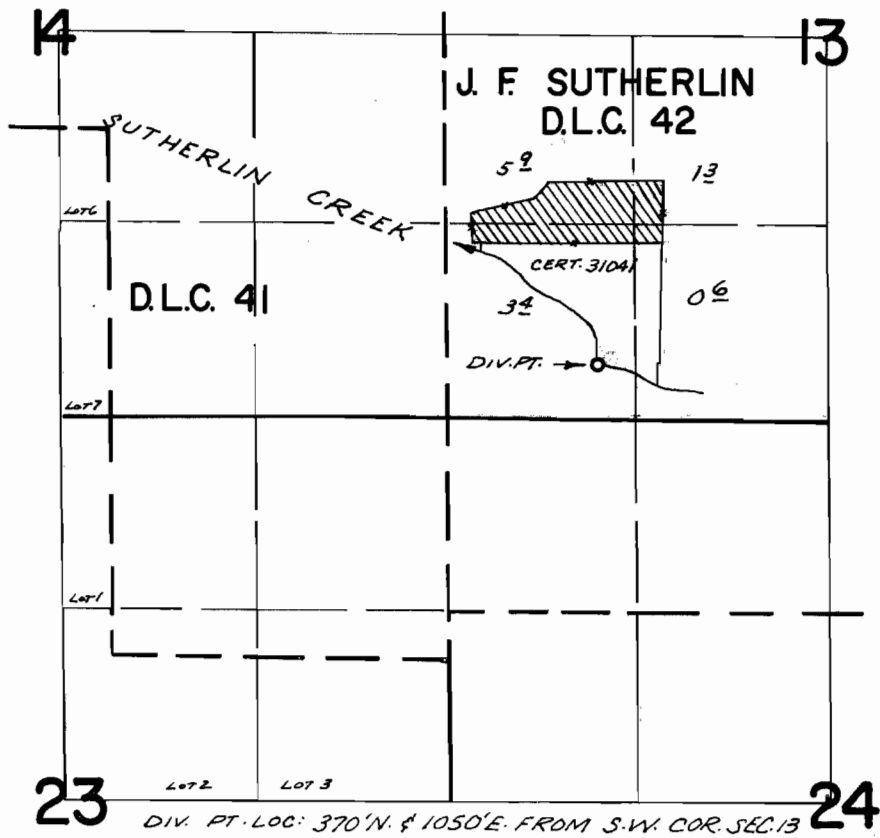

FINAL PROOF SURVEY
UNDER

Application No. 40541 Permit No. 30215
IN NAME OF

IVAN E. HOLM

Surveyed APR. 13, 1971, by G. BACA