


IN NAME OF

HENRY RICCO

Surveyed June 13, 1968, by L. E. Gould
 Aug. 30, 1971, by R. Mucken

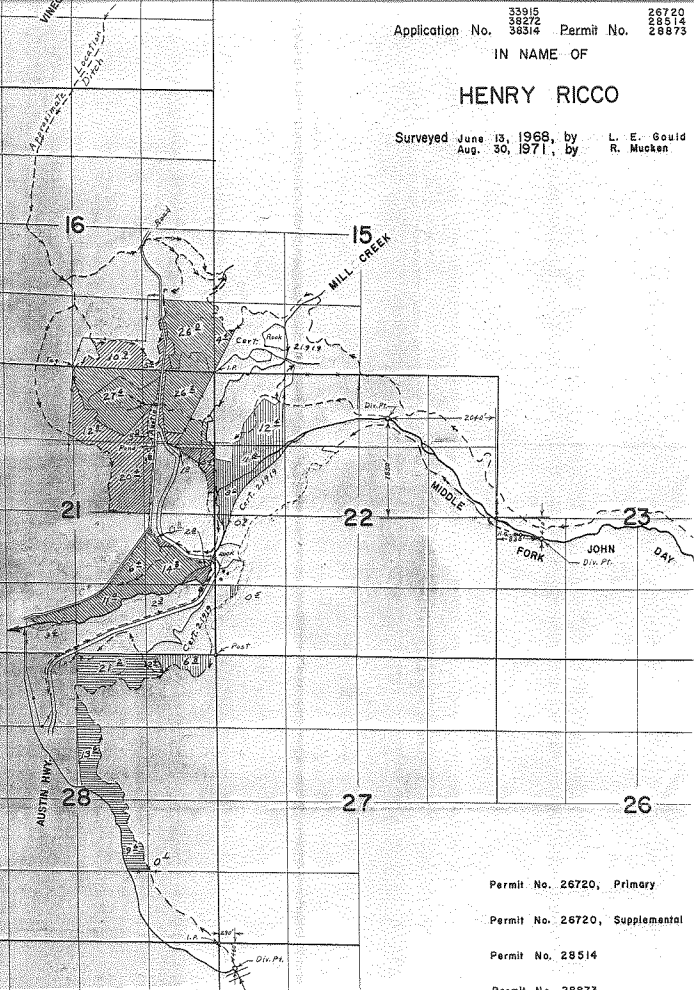

Permit No. 26720, Primary

Permit No. 26720, Supplemental

Permit No. 28514

Permit No. 28873

T. 11 S. R. 35 E. W. M.


FINAL PROOF SURVEY
UNDER

	33915		26720
	38272		28514
Application No.	38314	Permit No.	28873

IN NAME OF

HENRY RICCO

Surveyed June 13, 1968, by L. E. Gould
Aug. 30, 1971, by R. Mucken

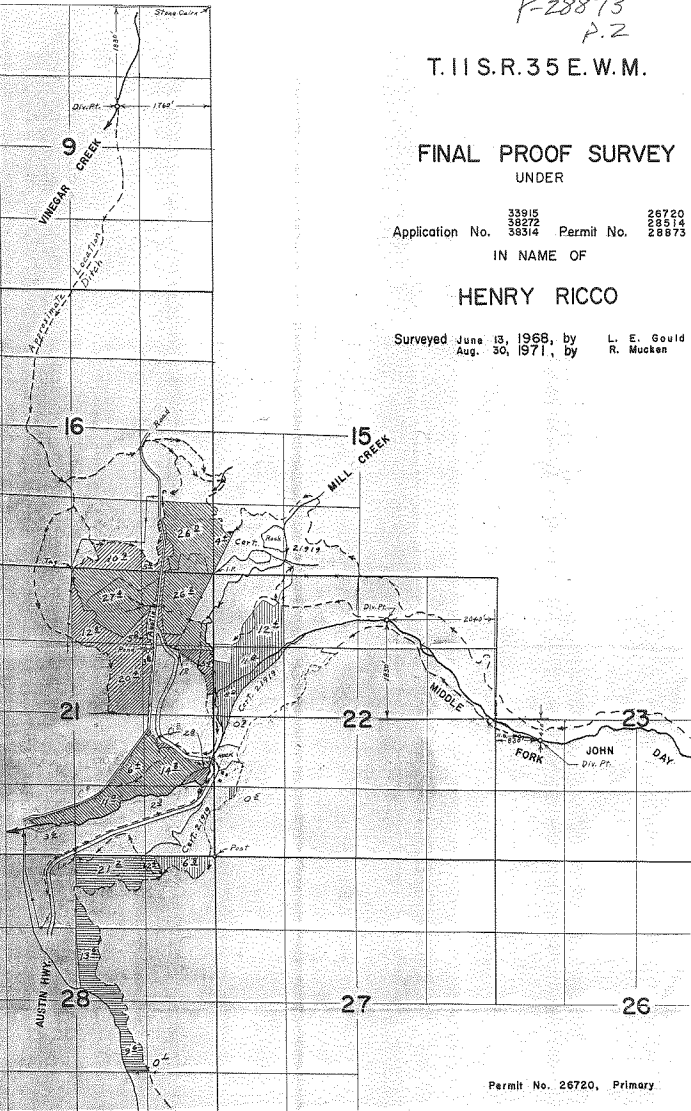

FINAL PROOF SURVEY UNDER

Application No. ³³⁹¹⁵38272 ²⁶⁷²⁰38314 Permit No. ²⁸⁵¹⁴28873

IN NAME OF

HENRY RICCO

Surveyed June 13, 1968, by L. E. Gould
Aug. 30, 1971, by R. Mucken

