


Application No. 33915 26720  
 38272 28514  
 38314 Permit No. 28873

IN NAME OF

HENRY RICCO

Surveyed June 13, 1968, by L. E. Gould  
 Aug. 30, 1971, by R. Mucken

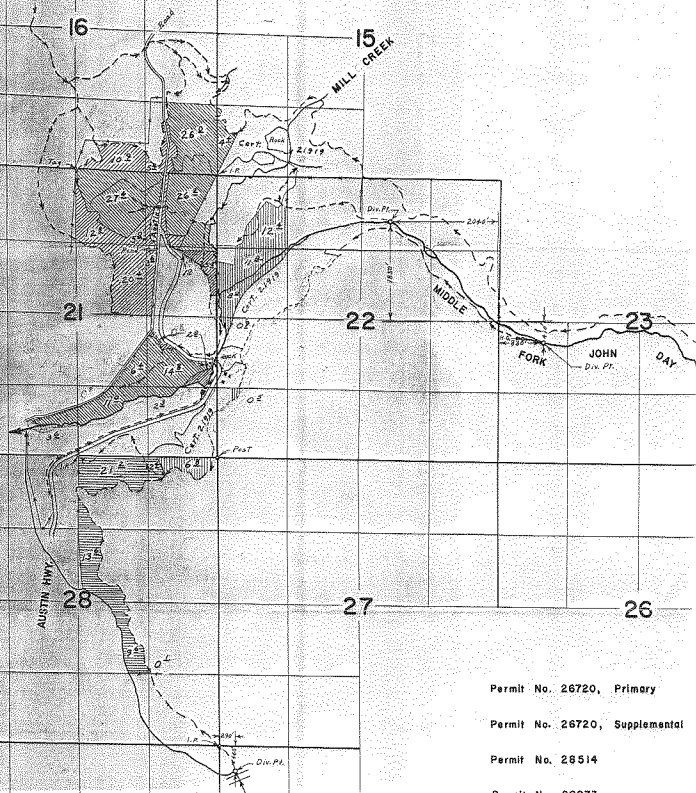

Permit No. 26720, Primary

Permit No. 26720, Supplemental

Permit No. 28514

Permit No. 28873


# FINAL PROOF SURVEY UNDER

Application No. <sup>33915</sup>3827238314 Permit No. <sup>26720</sup>2851428873

IN NAME OF

## HENRY RICCO

Surveyed June 13, 1968, by L. E. Gould  
Aug. 30, 1971, by R. Mucken

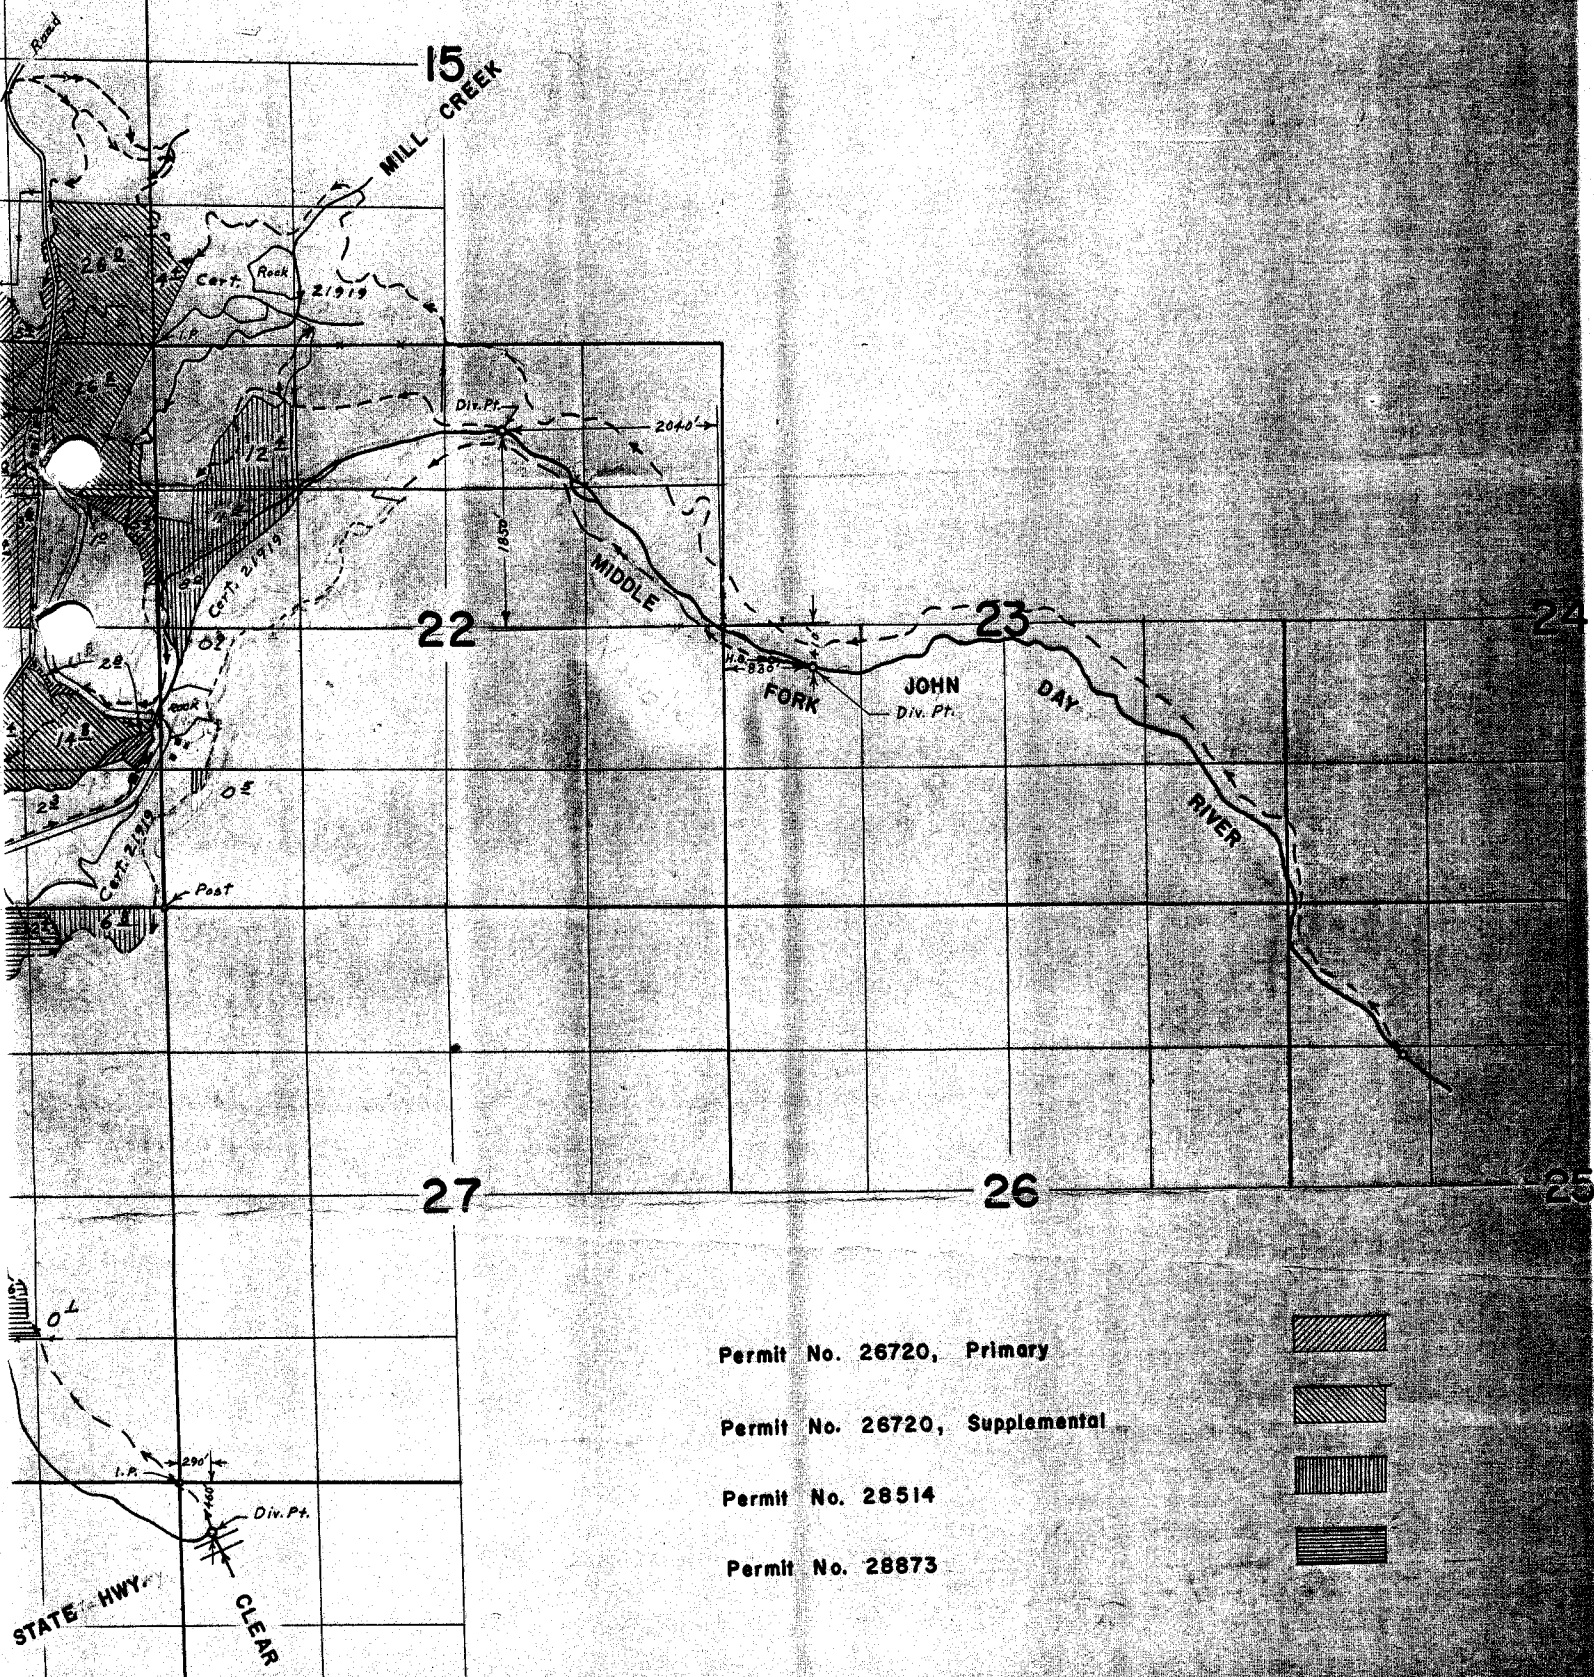

P-28873  
P.2

T.11S.R.35E.W.M.

# FINAL PROOF SURVEY UNDER

Application No. 33915 26720  
38272 28514  
38314 Permit No. 28873

IN NAME OF

HENRY RICCO

Surveyed June 13, 1968, by L. E. Gould  
Aug. 30, 1971, by R. Mucken

