


31037 39041

# T. 10S. R. 30E. W. M.

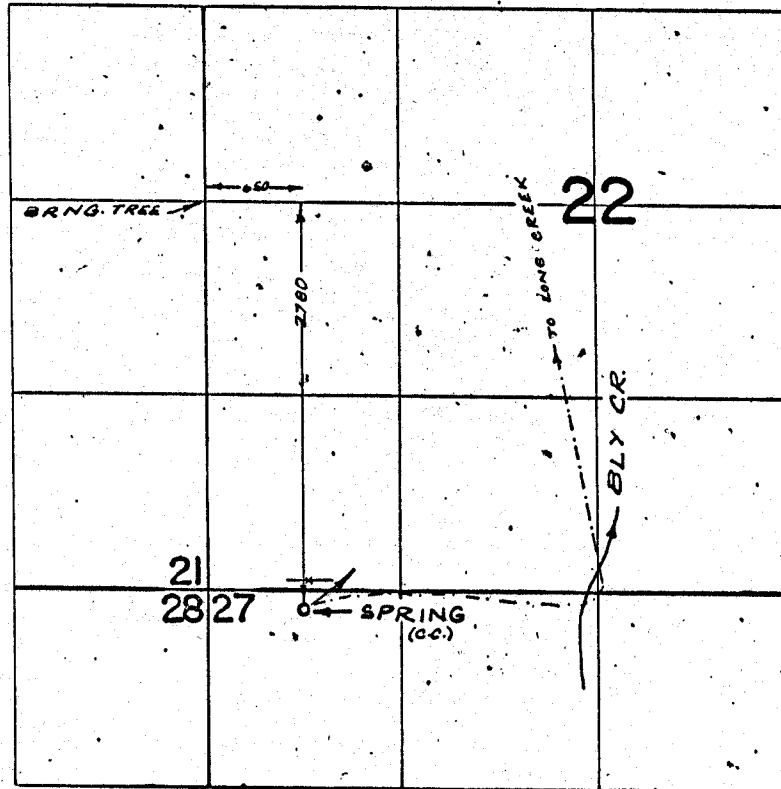

## FINAL PROOF SURVEY UNDER

Application No. 41688..... Permit No. 31037.....  
IN NAME OF

CITY of LONG CREEK

Surveyed SEPT. 26 1971, by R. MUCKEN