


31487

39842

T. 108 & 11 S. R. 26 E. W.M.

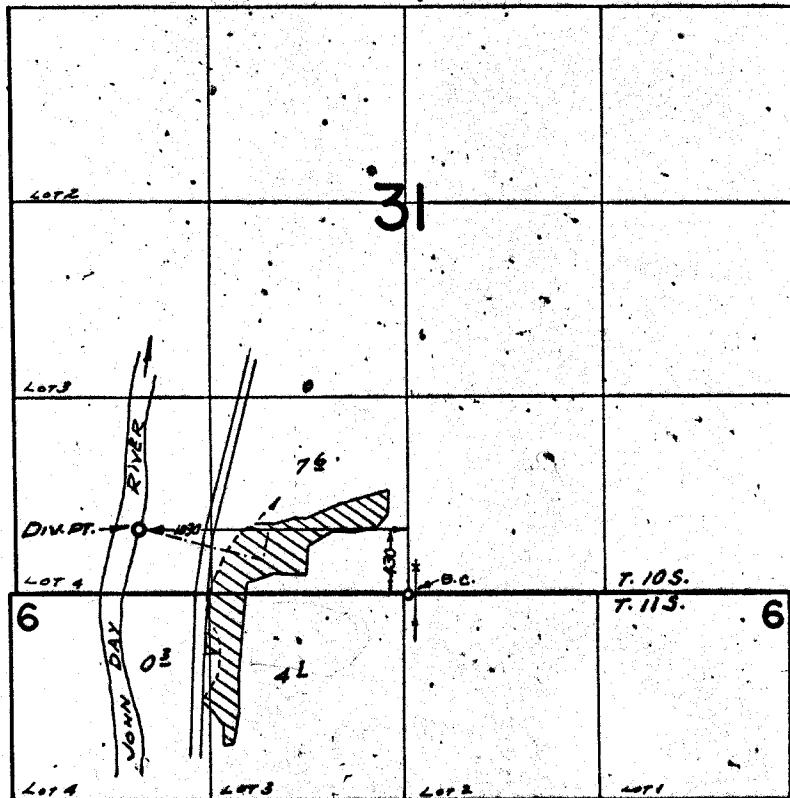

FINAL PROOF SURVEY UNDER

Application No. 42070... Permit No. 31487...
IN NAME OF

BERNARD FRANCIS & JUANITA O'ROURKE

Surveyed JULY 20, 1971... by R. MUCKEN...