


T.8&9S.R.27E.W.M.

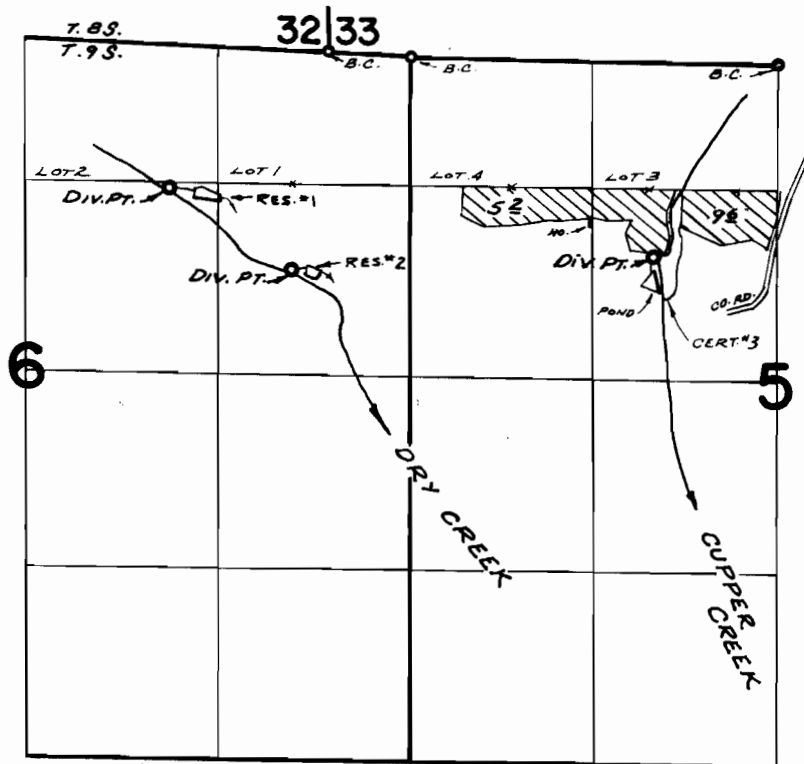

DIV. PTS. LOC: CUPPER CR. - 1330'S. & 1680'E. ; DRY CR. -
920'S. & 1650'W.; 1460'S. & 810'W., ALL FROM N.W. COR. SEC. 5

FINAL PROOF SURVEY UNDER

Application No. R-43407 43408 Permit No. R-4982 32456
IN NAME OF

L. D. VINSON

Surveyed JULY 21, 1971, by R. MUCKEN