


T. 24 S. R. 30 E. W. M.

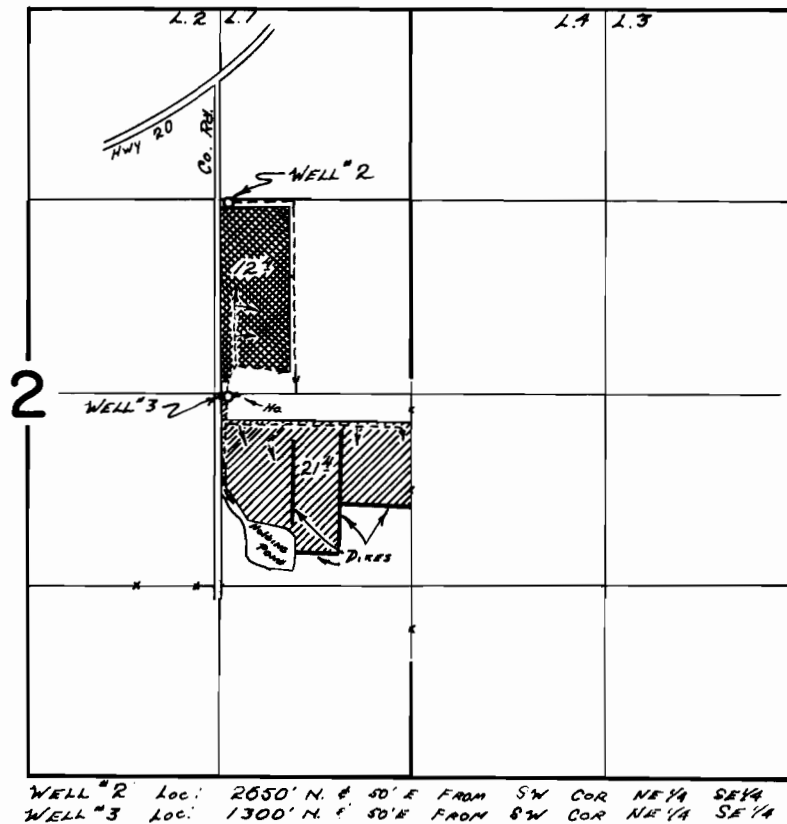

FINAL PROOF SURVEY UNDER

Application No. G-3509 Permit No. G-3303
IN NAME OF

GUSTAVE NEUMANN

Surveyed Aug. 28 1972, by R. G. MUCKEN