


Superseded by 1972 Map

T. 1 N. R. 9 & 10 E. W. M.

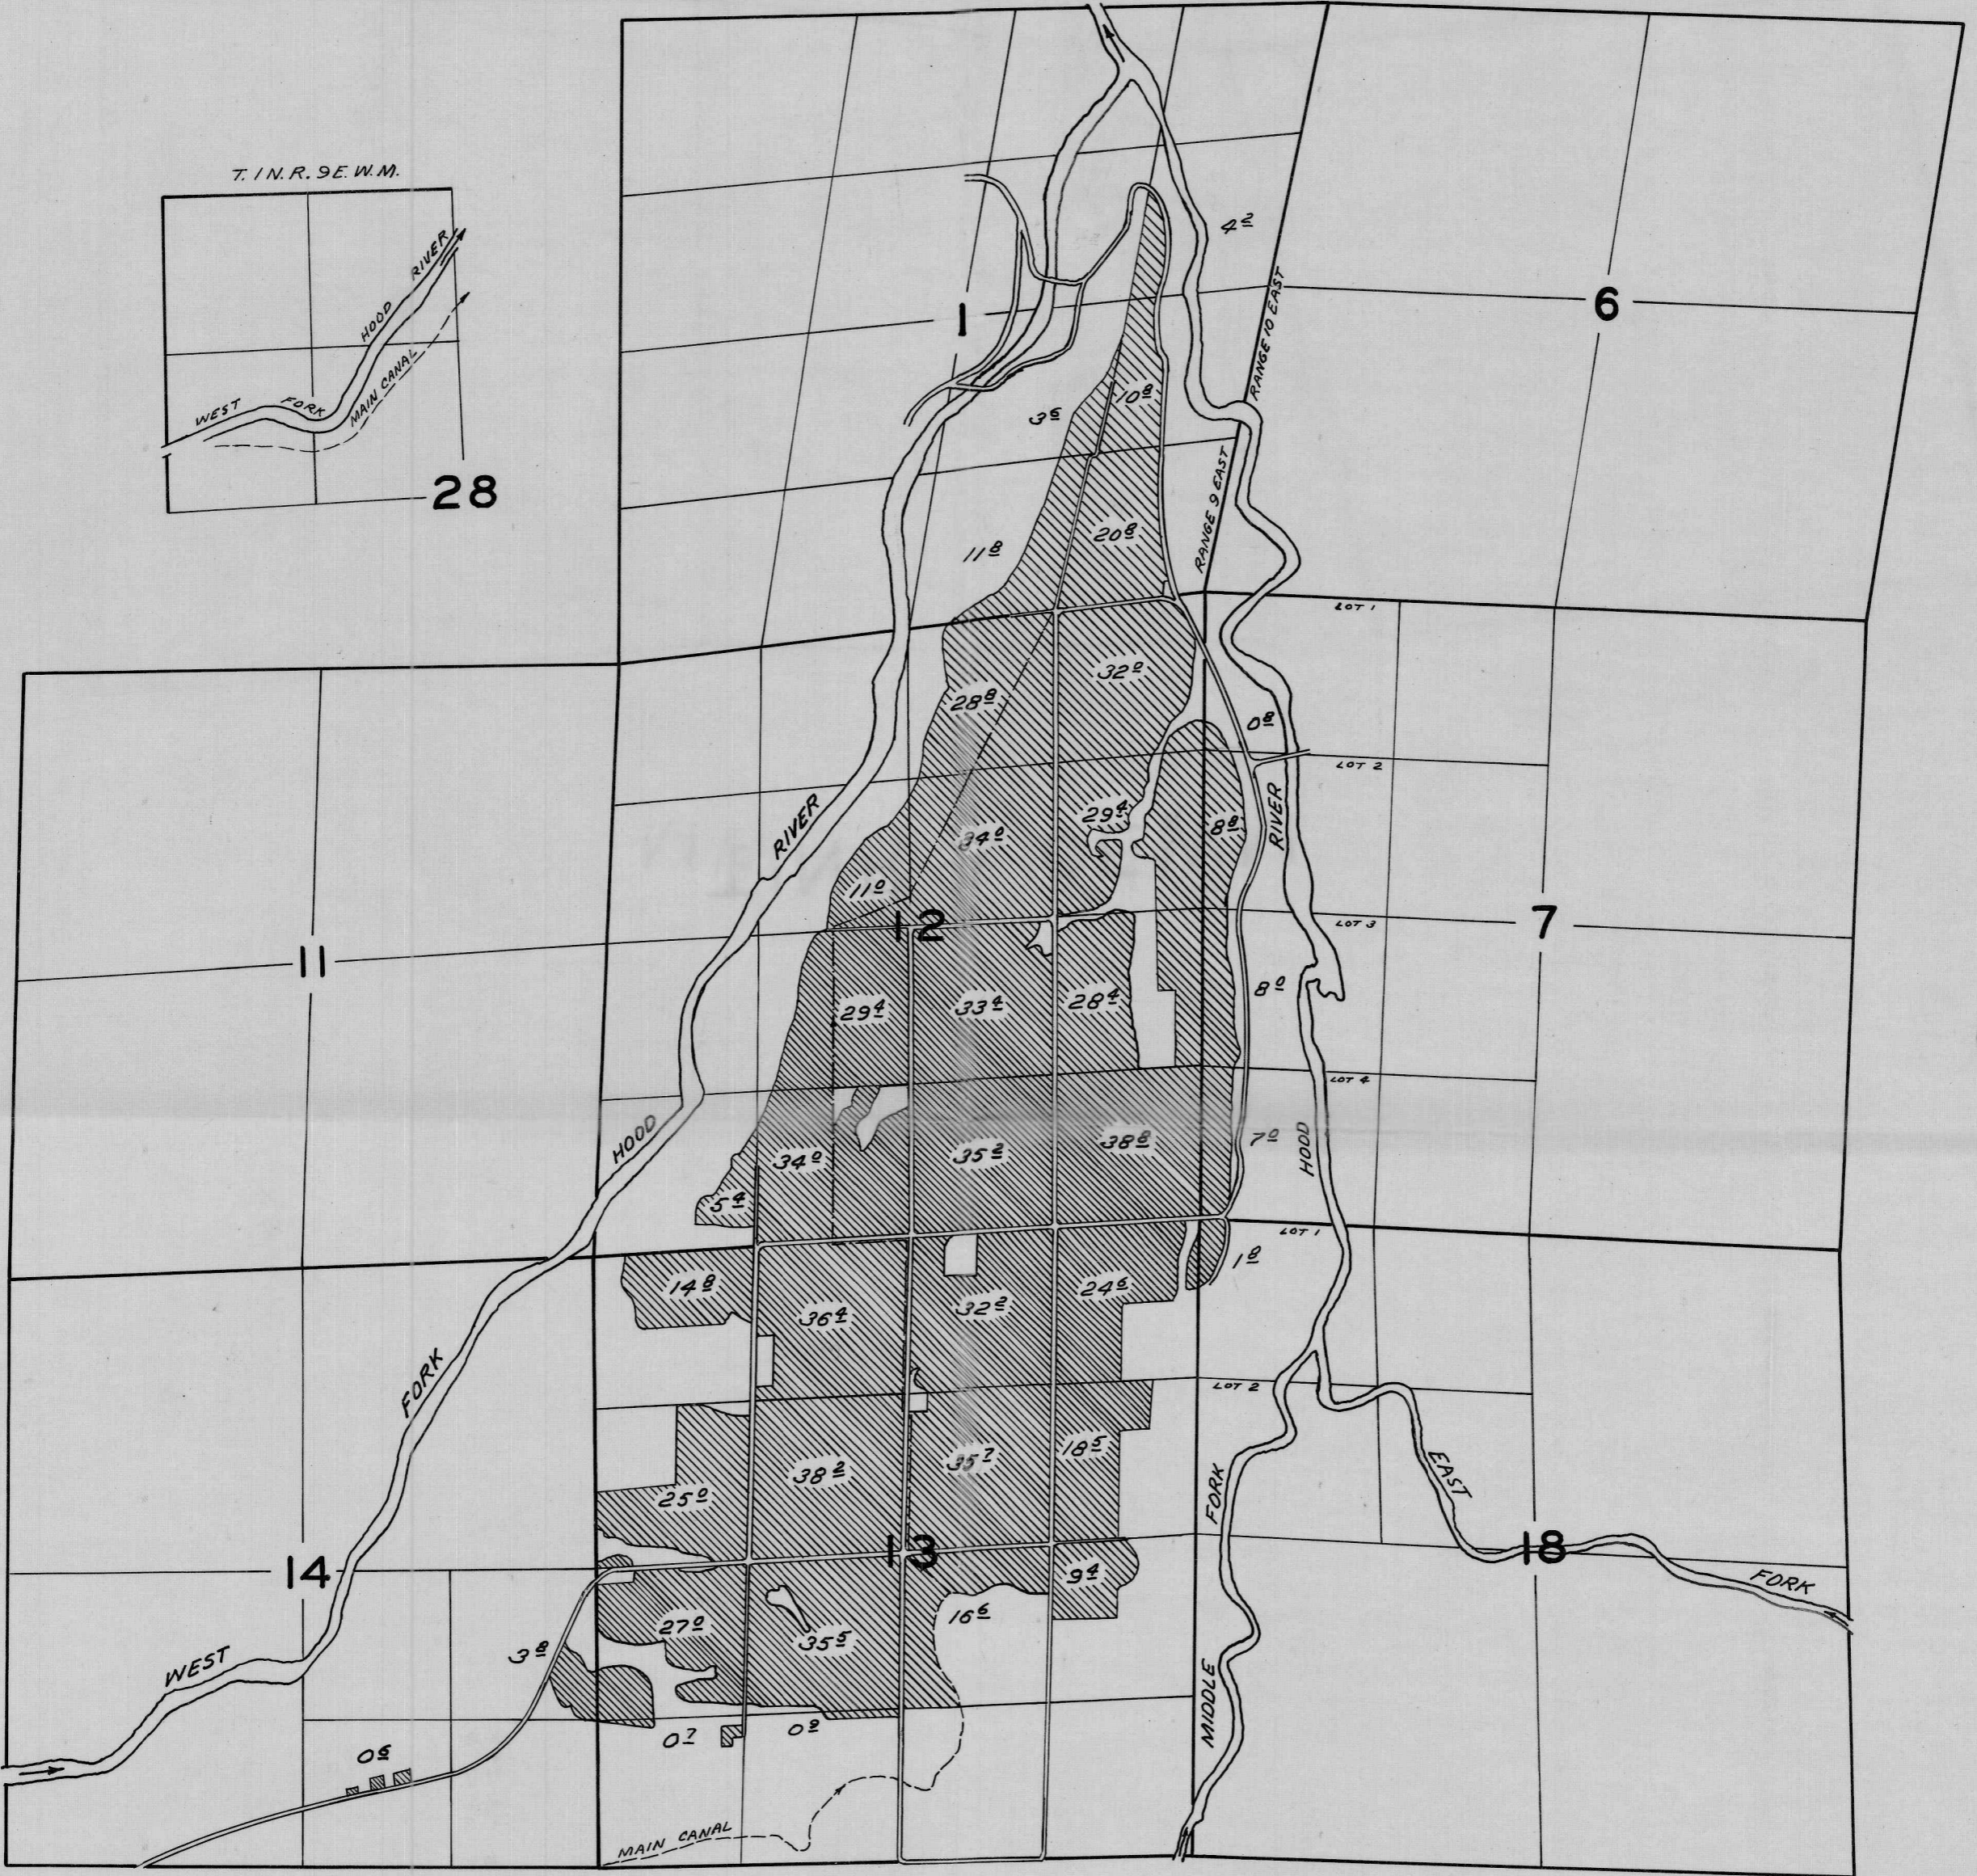

FINAL PROOF SURVEY

UNDER

APPLICATION NO. 298, PERMIT IT NO. 165

IN NAME OF

DEE IRRIGATION DISTRICT

L. JEBOUSEK

1965 BY