N

SW ¼ of SE ¼ section 21, T. 2 N
R 10 E W. M.

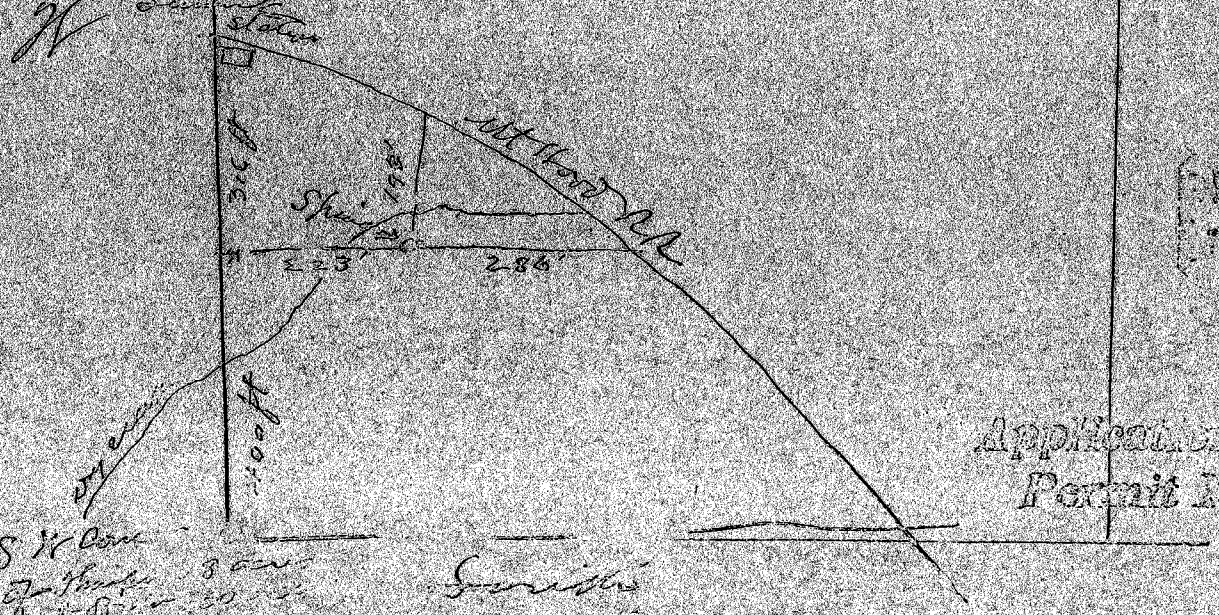

E

Application No. 6450
Permit No. 4062

4062