


T.1N.R.9E.W.M.

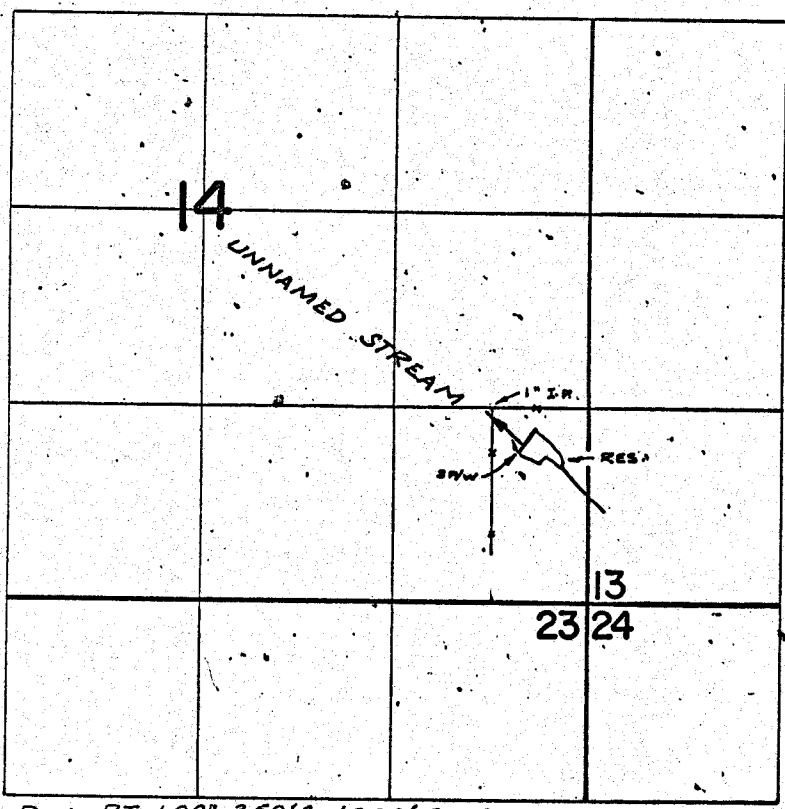

DIV. PT. LOC^d 250'S. 1220'E. FROM N.W. COR.
 E 1/4 SE 1/4 SE 1/4 SEC. 14

FINAL PROOF SURVEY UNDER

Application No. ^{R-31810} 31811 Permit No. ^{R-2783} 27843
 IN NAME OF

ELDORA FRASER

Surveyed APR. 12 1971, by G. BACA