


# T.1N.R.9E.W.M.

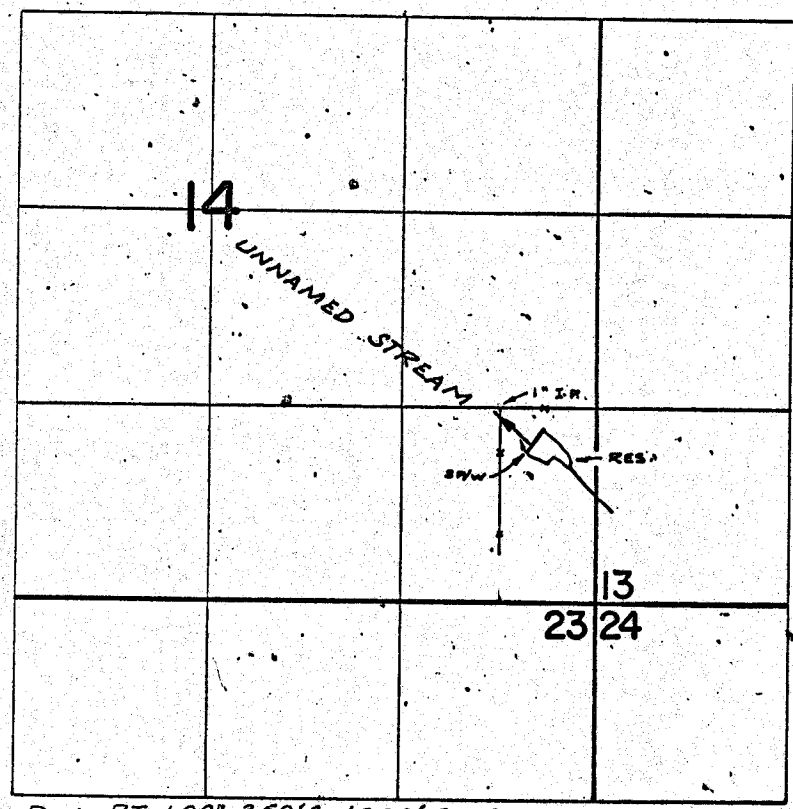

DIV. PT. LOC. 250'S. 1220'E. FROM N.W. COR.  
 E 1/2 SE 1/4 SE 1/4 SEC. 14

## FINAL PROOF SURVEY UNDER

Application No. R-31810 31811 Permit No. R-2783 27843  
 IN NAME OF  
ELDORA FRASER

Surveyed APR. 12 1971, by G. BACA