


T. 2 N. R. 10 E. W. M.

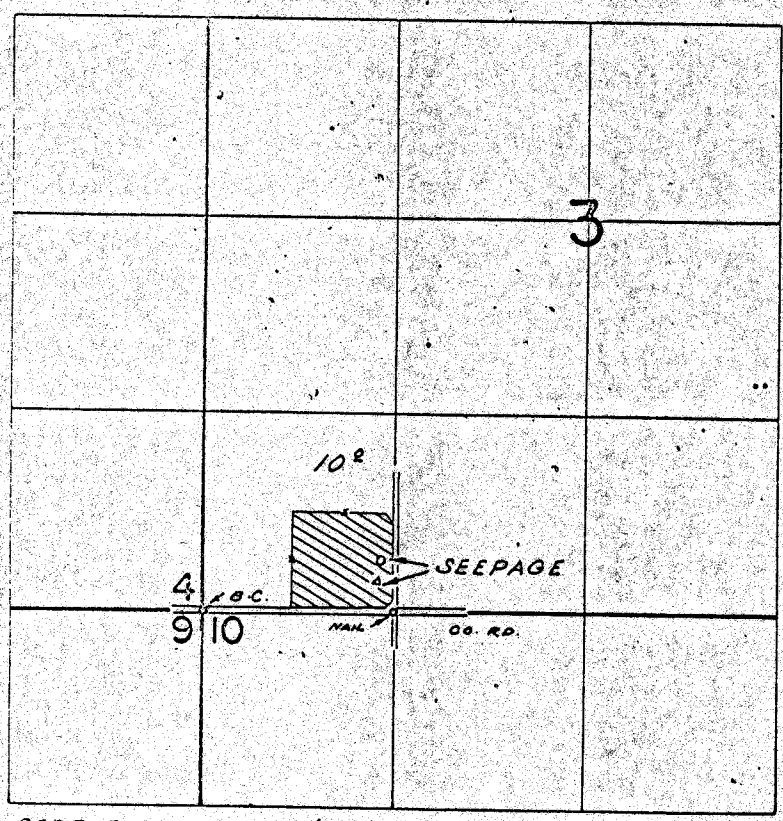

SEEPAGES LOC: 200' N. & 1200' E.; 350' N. & 1220' E.,
 BOTH FROM S.W. COR. SEC. 3

FINAL PROOF SURVEY UNDER

Application No. 38181 Permit No. 28458
 IN NAME OF
JOE HESS

Surveyed APR. 21, 1971 by G. BACA