


30641

T.2N.R.10E.W.M.

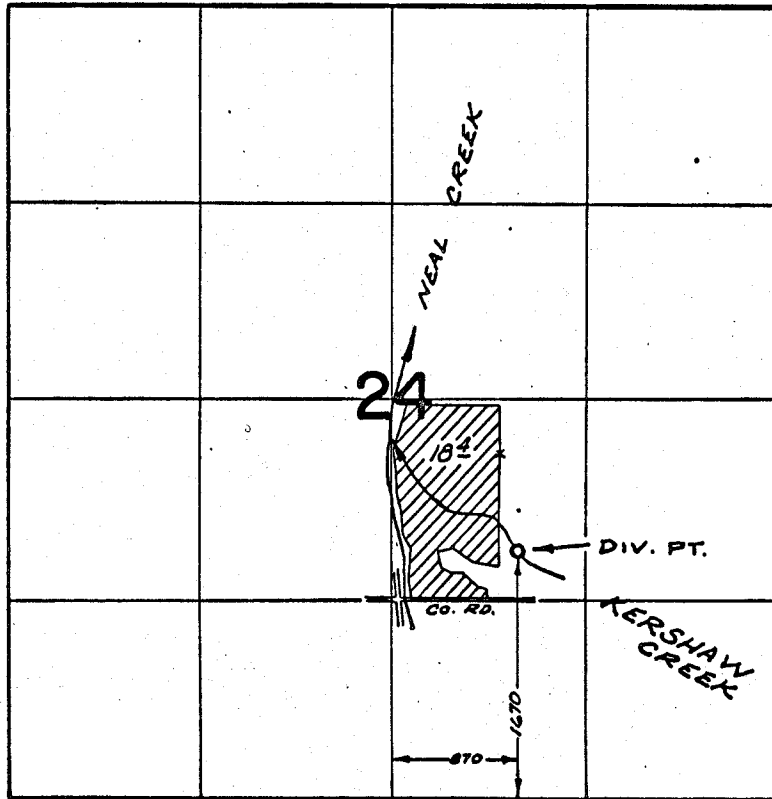

FINAL PROOF SURVEY UNDER

Application No. 41056 Permit No. 30641
IN NAME OF

DANIEL SWAN

Surveyed APR. 23, 1971, by G. BACA

R.G.M.
1971-A