


T. 38 S. R. 1 W. W. M.

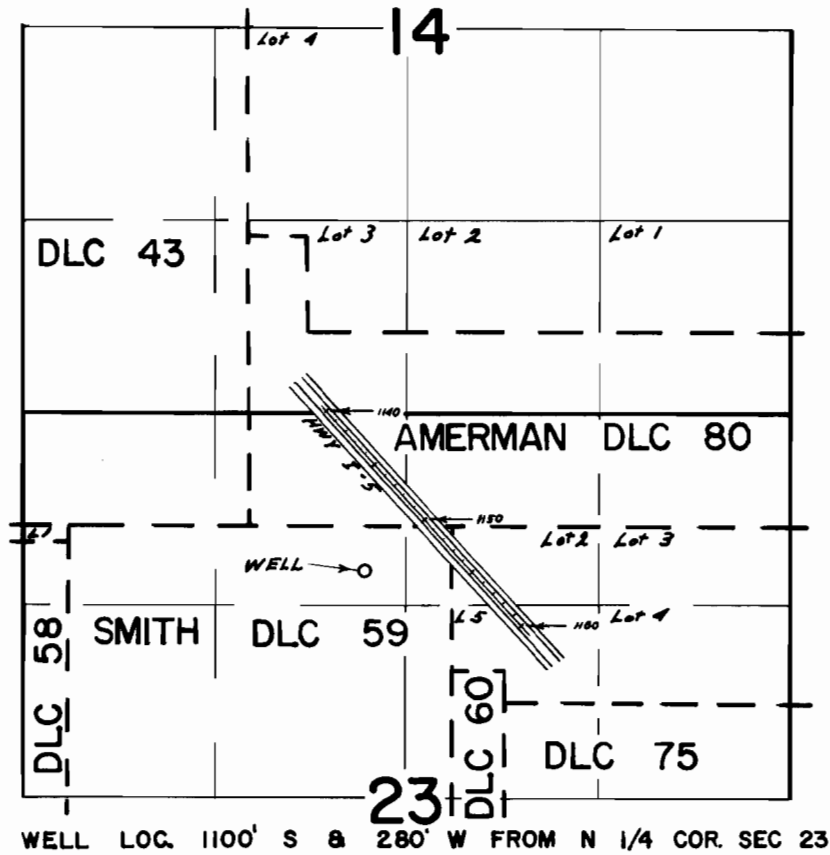

FINAL PROOF SURVEY
UNDER

Application No. G-3335 Permit No. G-3132.
IN NAME OF

OREGON STATE HIGHWAY COMM.

Surveyed OCT. 15, 1971, by R. MUCKEN