


T. 38S.R.3W.W.M.

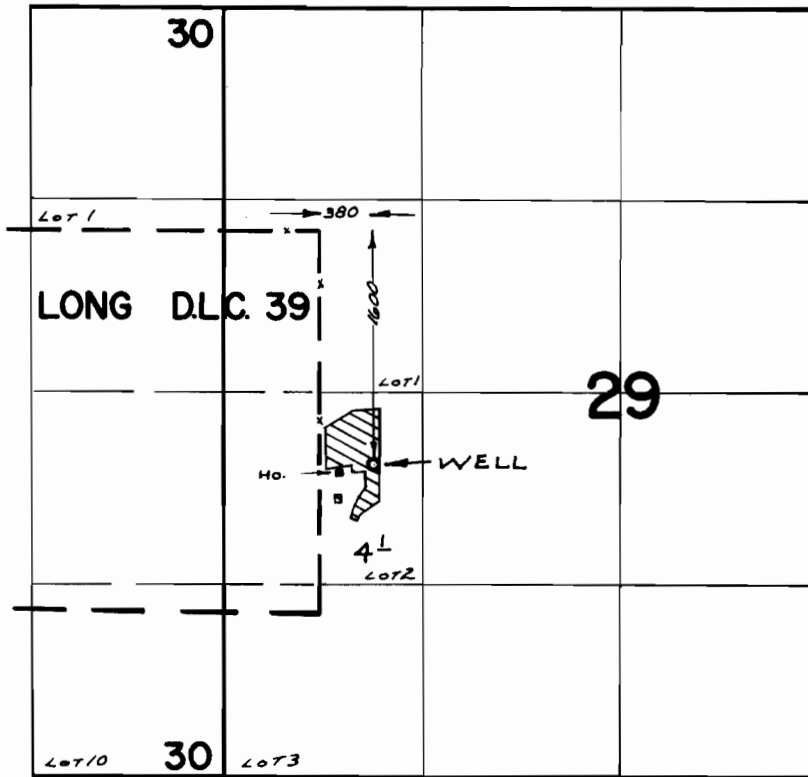

FINAL PROOF SURVEY
UNDER

Application No. G-3422 Permit No. G-3208
IN NAME OF

CHARLES A. CRANE

Surveyed AUG. 12 1971, by G. BACA