


T. 38 S. R. 1 W. W. M.

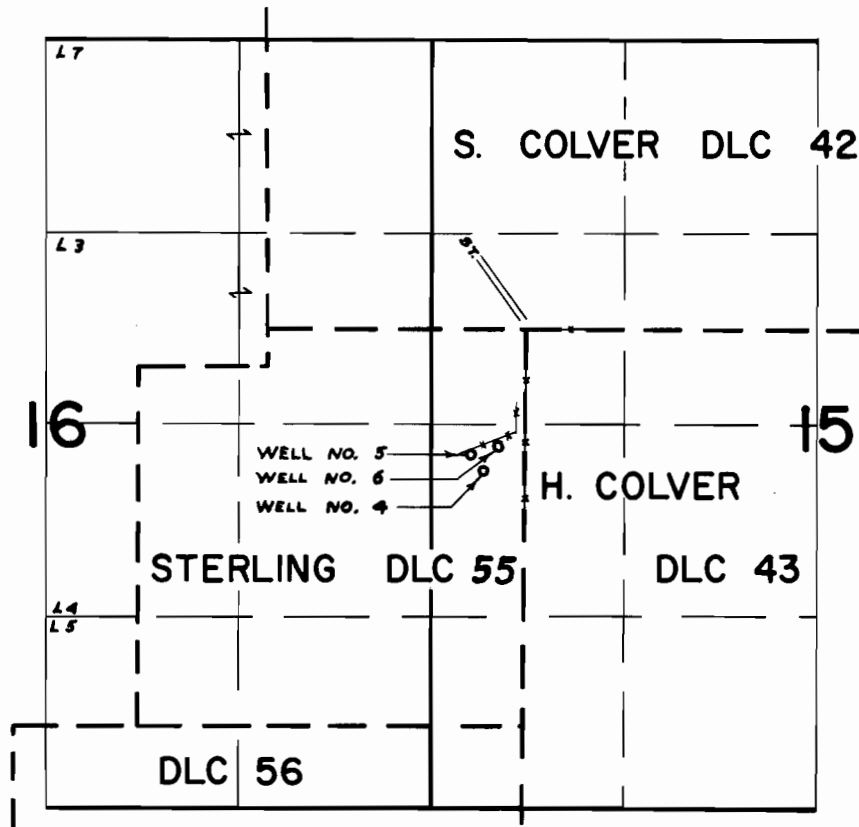

WELLS LOC.; WELL 4-970' S & 280' W ; WELL 5-860' S & 360' W ; WELL 6-810' S & 180' W ALL FROM NE COR. STERLING DLC 55

FINAL PROOF SURVEY UNDER

Application No. G-4084. Permit No. G-3837.
IN NAME OF

CITY OF PHOENIX

Surveyed OCT. 19, 1971, by R. MUCKEN