


T. 39S. R. 3W. W.M.

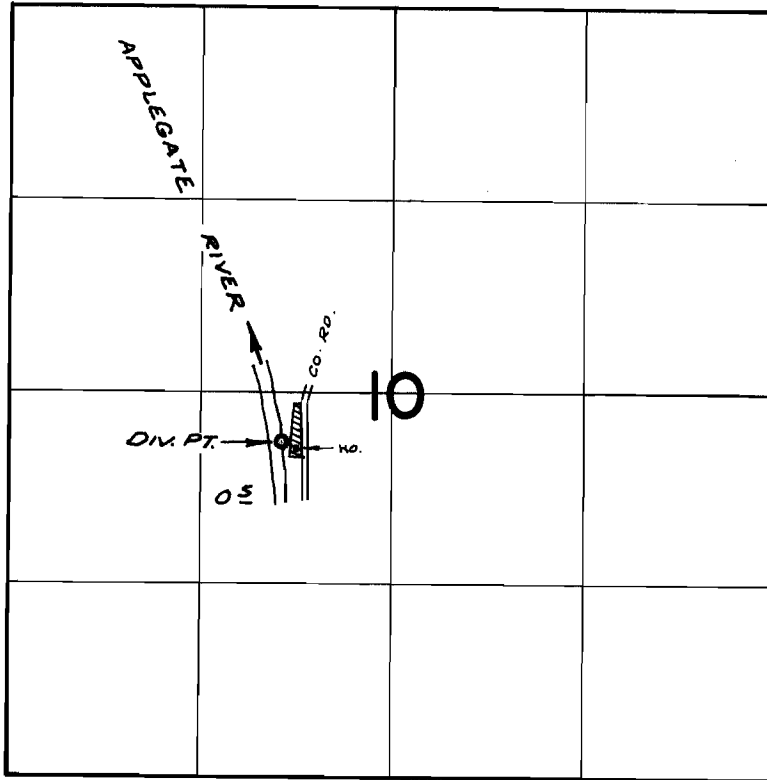

DIV. PT. LOC: 2300' N. & 760' W. FROM S $\frac{1}{4}$ COR. SEC. 10

FINAL PROOF SURVEY
UNDER

Application No. 39813 Permit No. 29588
IN NAME OF

HUBERT WILLIAM BARKER

Surveyed AUG. 10, 1971, by G. BACA