


T. 33 & 34 S. R. 1 W. W. M.

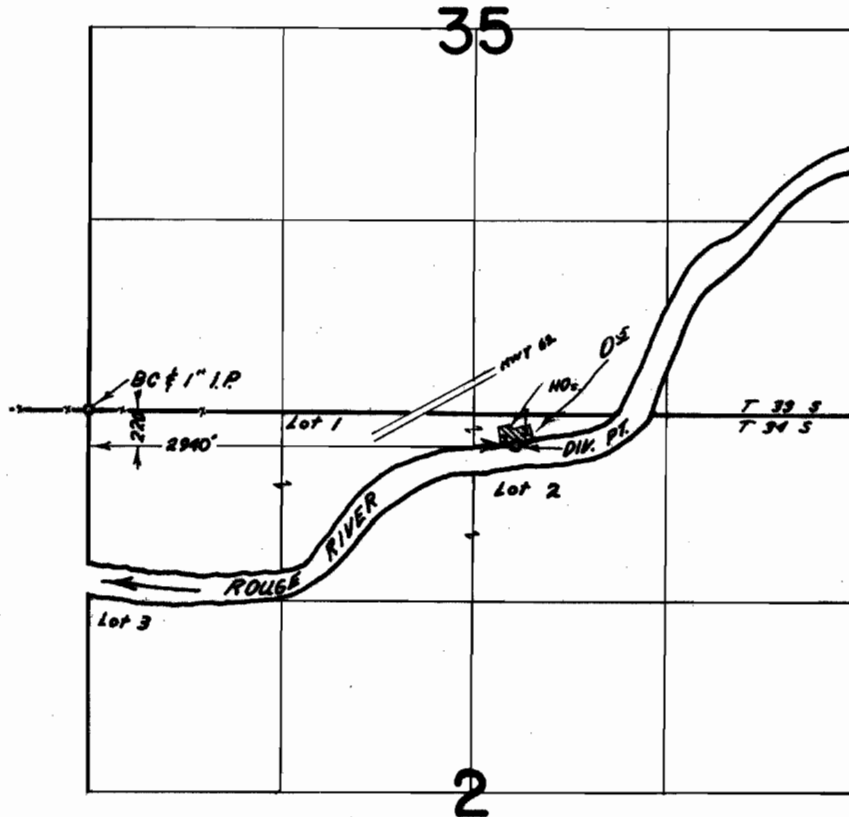

FINAL PROOF SURVEY
UNDER

Application No. 44963... Permit No. 33606...
IN NAME OF

.....FLORENCE E. CLEARY.....

Surveyed OCT. 21, 1971., by R. MUCKEN.....