

THE COVE PALISADES STATE PARK


WATER RIGHT APPLICATION

JEFFERSON COUNTY

T. 12 S., R. 12 E., W.M.

1" = 800'

12-20-67

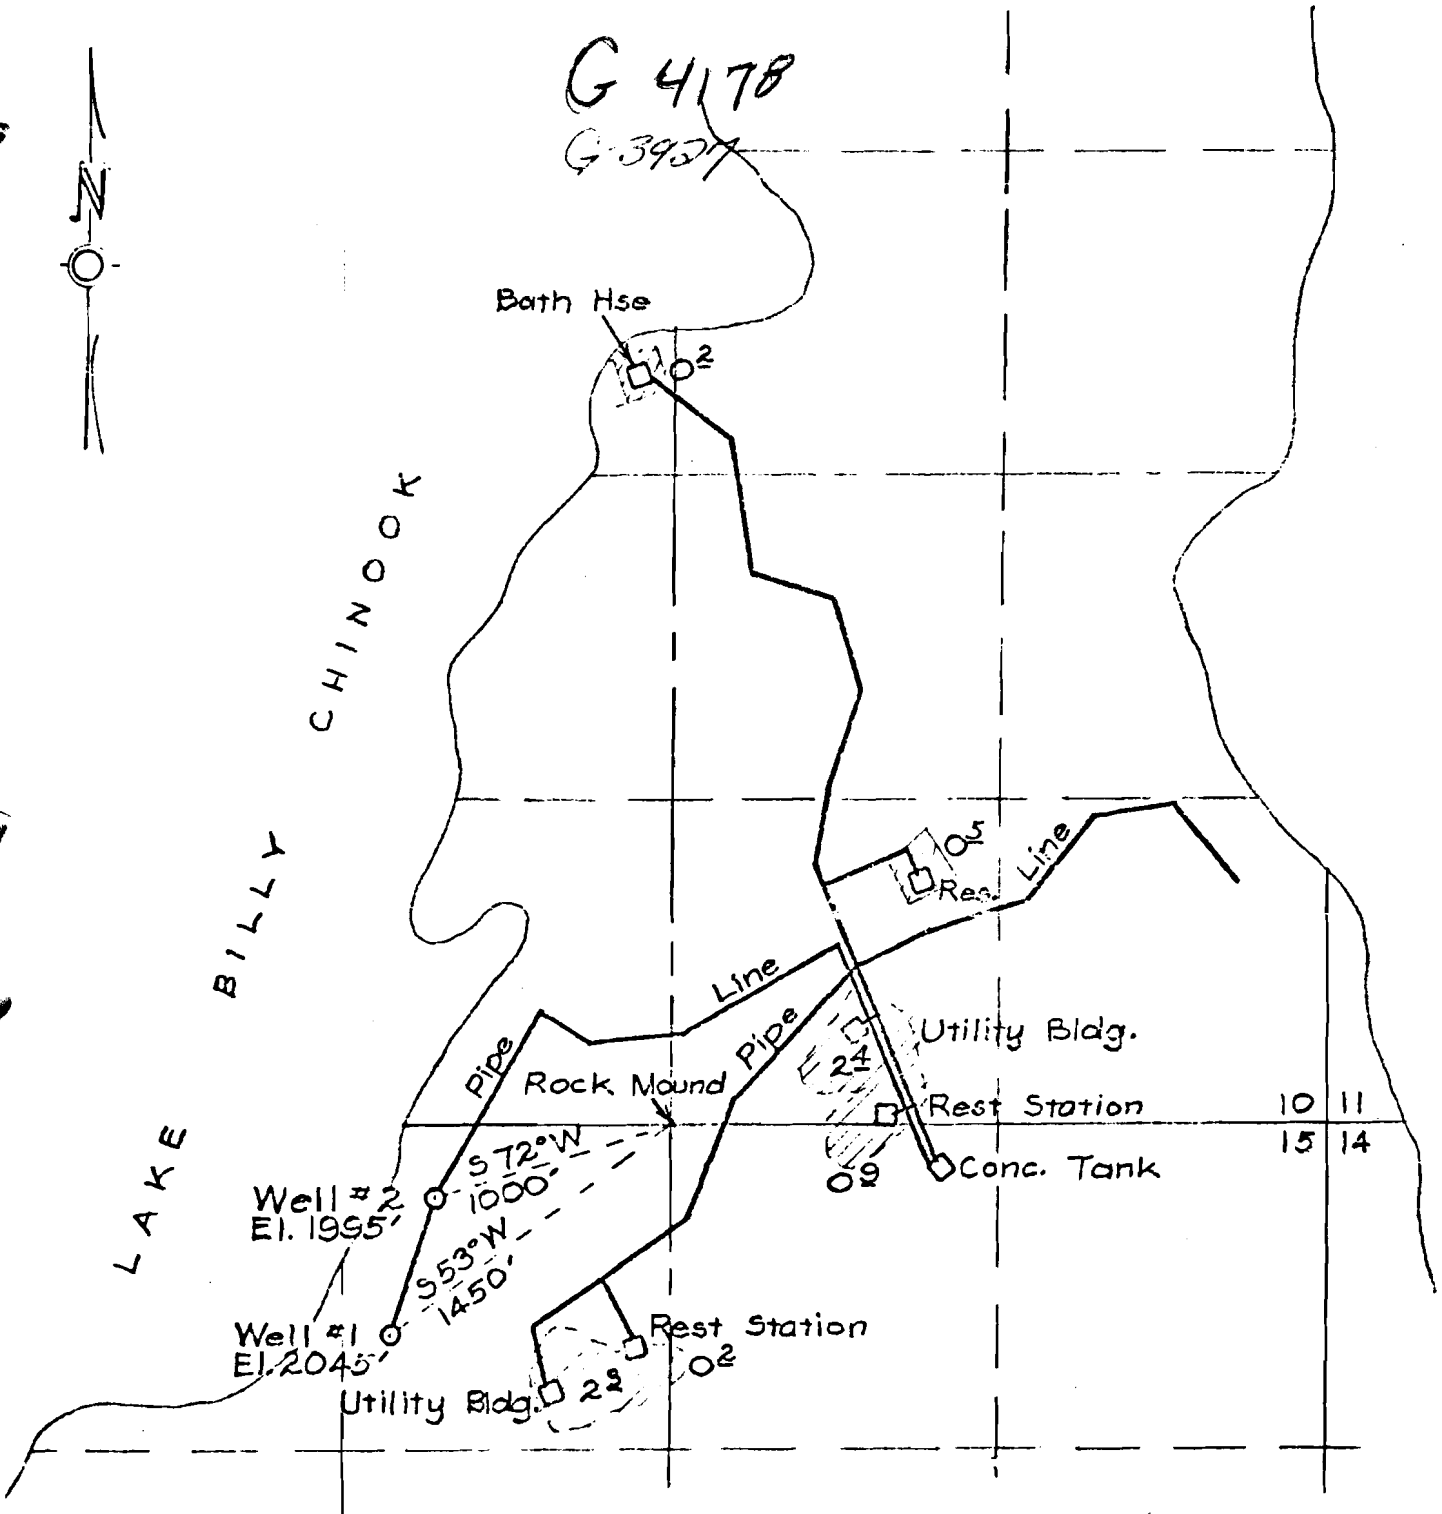

G 4178
G 3927

10 11
15 14

9-3927