


T. 19 S. R. 12 W. W. M.

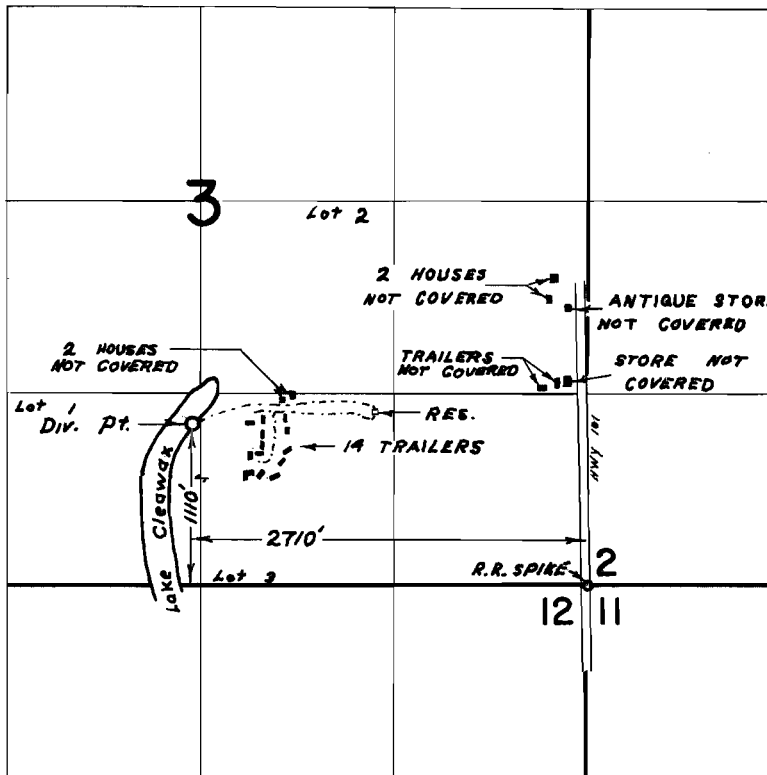

**FINAL PROOF SURVEY**  
UNDER

Application No. 40462... Permit No. 30065..  
IN NAME OF

WESTERN AMERICAN DEVELOPMENT CO.

Surveyed OCT. 20, 1971, by L. E. Gould.....