


T. 10 S., R. 10 W. W.M.

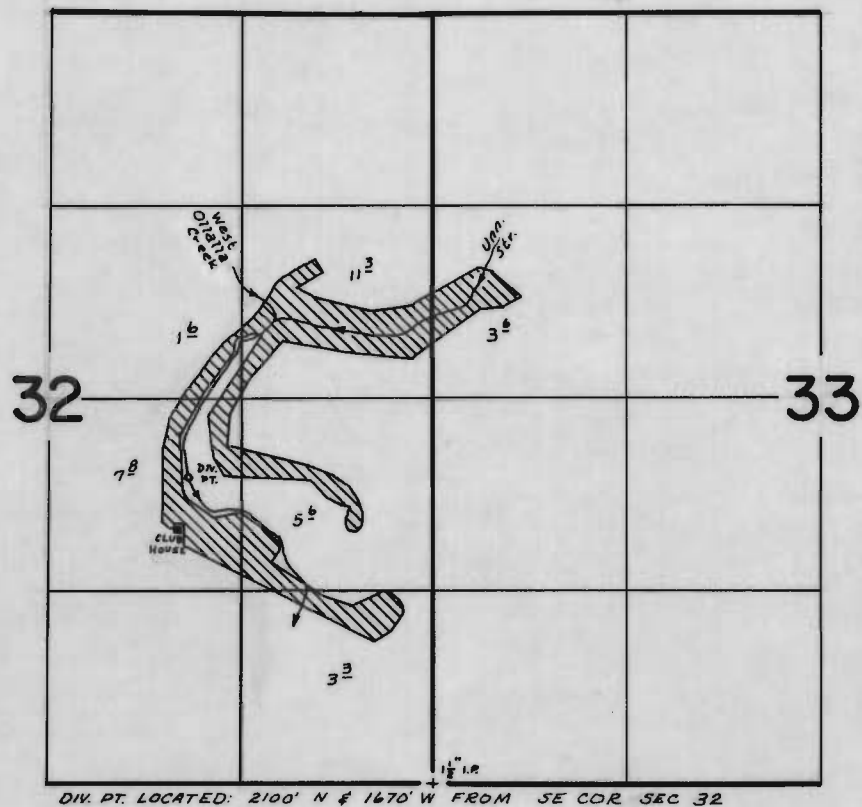

FINAL PROOF SURVEY
UNDER

Application No. 42140 Permit No. 31711
IN NAME OF

MATTHEW GRUBER

Surveyed Aug. 23 1972, by D. Norby